

LAND CORNER RECORDATION CERTIFICATE

FILING REQUIREMENT OF ACT 74, MICH. P.A.1970

FOR CORNERS OF--	LOCATED IN--	CORNER CODE NUMBER
1. PUBLIC LAND SURVEY	T. 25 N. R. 13 W.	C-6; C-9; E-7; E-9
2. PROPERTY CONTROLLING IN SECTION	17, T. 25 N. R. 13 W.	14
3. MISCELLANEOUS PROPERTY IN SECTION	T. S. R. E. W.	
4. LOT NO. _____, RECORDED PLAT _____		
5. PRIVATE CLAIMS _____		

REGISTER OF DEEDS STAMP AND FILING NUMBER

I, Carl F. Roser, do hereby certify that under requirements of P.A. 74, Michigan P.A. of 1970, the corner points mentioned in lines 1 and 2 above were, in a field survey on September 24, 1975, established, re-established, monumented, re-monumented, recovered or restored as expressed below and in conformance with regulations and rules therefore as required in the current manual of survey instructions of the United States Department of the Interior, Bureau of Land Management or by a decree of a court of law. Furthermore, that the corner points mentioned in lines 3, 4 and 5 above were, in a field survey on _____, 19____, found, recovered, restored, established or re-established as expressed below and in conformance with the rules of the Michigan State Board of Registration for Land Surveyors or, by a Decree of a Court of law:

A. Description of original monument and accessories and/or subsequent restoration:

C. (continued)

E-9	14
Fd. 1 1/2" pipe IN N-S dirt road	Set 1"x30" pipe
8" Cherry N86°W 38.5	7" R.Pine N75°E 72.97
4" Cherry N70°W 62.1	16" B.Cherry S30°E 121.17
12" Cherry N34°E 64.9	7" R.Pine S49°W 36.98
Set cedar post w/loc. tag	Set cedar post w/loc. tag
Due E 33'	Due W 33'
	Ctr. N-S dirt road Due W 4'±

B. Description of corner evidence found and/or method applied in restoring or re-establishing corner:

- C-6 Found std. Benzie Co. monument for W 1/4 Sec. 17 per H.R. Bruning survey in ctr. N-S gravel rd.
- C-9 Recovered bottom 2' of "Haswell" pointed stake (charred cedar). Set old stake bottom on S side of 1 1/2" pipe in bottom of hole. Corner is in line w/irregular fence E to RR track. Deceased co. surveyor's notes dated Aug. 1907 call for "planted a charred cedar 4", 3' long, with shovel."
- E-7 Fd. 1/2" rered by Bruning who restored this corner prorated to Pettitt survey in sec. 17.
- E-9 Recovered 1 1/2" pipe as called for in co. surveyor's notes dated Aug. 1907. Haswell notes say he set 1 1/2" iron pipe from original U.S. witness trees.
- 14 Established corner per standard B.L.M. instructions.

C. Description of monument for corner and accessories established to perpetuate locating the position of the corner:

C-6	C-9	E-7
Found Benzie Co. mon.	Set 1 1/2"x36" pipe	Fd. 1/2"x2' rered & ced.post & added
Cedar post/loc.tag Due W 33'	Apple clump S18°W 23.25	1 1/2"x3' pipe
9" Maple N73°E 19.63	10" J.Pine N35°W 64.04	12" Cherry S73°E 101.2
14" Maple S20°E 58.18	10" J.Pine S68°W 78.74	14" Cherry N57°E 115.8
22" Tri-Maple N77°W 19.10	Ctr. gravel Rd. W South 8'	7" R. Pine N19°W 142.1
	In line w/ctr.gravel road	Ced/post w/loc. tag
	North	Due E 33'
	Set ced.post w/loc. tag	
	East 33'	


SIGNED BY Carl F. Roser DATE 10-6-75

SURVEYOR'S MICHIGAN REGISTRATION NO. 12028

FOR STATE AND UNITED STATES AGENCIES:

SIGNED BY _____ DATE _____

APPROVED AND SIGNED BY _____ DATE _____

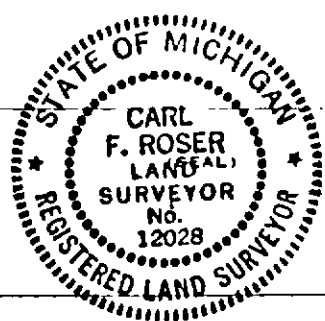

SURVEYOR'S MICHIGAN REGISTRATION NO. _____

COLFAX TOWNSHIP
BENZIE COUNTY