

**SURVEY &  
REMONUMENTATION**

SEP 30 1999

LIBER 2 PAGE 36

**SECTION**

**LAND CORNER RECORDATION CERTIFICATE  
Filing Requirement of Act 74, Mich. P.A. 1970**

STATE OF MICHIGAN  
BENZIE COUNTY  
RECORDED

29 DEC 94 4:43 P.M.

MICHELLE R. GRAY  
REGISTER OF DEEDS

For corners in

Benzie  
(County)

Located In:

Corner Code #

T 25N R 13W

A-5 ✓  
M-5

1. Public Land Survey

T 25N R 14W

T R

T R

T R

2. Property Controlling  
in Section

S T R

S T R

3. Miscellaneous  
Property in Sec.

S T R

S T R

Register of Deeds Stamp & File Number

4. Lot No. \_\_\_\_\_, Recorded Plat \_\_\_\_\_

5. Private Claims \_\_\_\_\_

	A	B	C	D	E	F	G	H	I	J	K	L
2	6		5		4		3		2		1	
3												
4	7		8		9		10		11		12	
5												
6	18		17		16		15		14		13	
7												
8	19		20		21		22		23		24	
9												
10	30		29		28		27		26		25	
11												
12	31		32		33		34		35		36	
13												

I, John B. Smendzuik, in a field survey on December 16 and 23, 19 94, do hereby certify that under requirements of P.A. 74, Michigan P.A. of 1970, the corner points mentioned in lines 1 and 2 above were in conformance with regulations and rules therefore as required in the current manual of survey instructions of the United States Department of the Interior, Bureau of Land Management or by a decree of a Court of Law and/or that the corner points mentioned in lines 3, 4 and 5 above were in conformance with the rules of the Michigan Board of Land Surveyors or by a Decree of a Court of Law; established, re-established, monumented, re-monumented, recovered, found as expressed below:

**NOTE: Not more than 4 corners, all in the same town and range, may be recorded on this certificate.**


A. Description of original monument and accessories and/or subsequent restoration:

M-5: G.L.O. set post - 12" Beech N87°W 24.42', 13" Beech S55°W 33.00'. James Pettit, Surveyor Record II, Page 8, set post from original trees. Frank Haswell, Surveyor's Record II, Page 82, found old corner and planted iron bolt, 1 1/4" in diameter. 1970 - B.C.R.C. - found 1 1/4" iron - 1' deep. 1982 - Harold R. Bruning - found 1 1/4" iron bolt, filed Act 74. 1984 - B.C.R.C. - set railroad spike after repave of County Road 669.

B. Description of corner evidence found and/or method applied in restoring or reestablishing corner:

M-5: Found 1 1/4" x 14" iron bolt approximately 8" below road grade.

Ratified by Peer Group  
In accordance with P.A. 345  
Chairman [Signature]  
Date 12/19/94

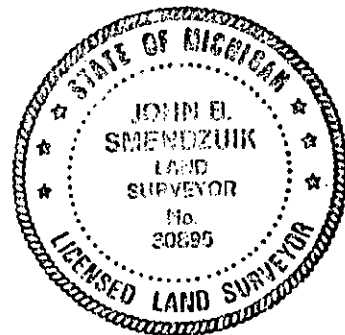

C. Description of monument for corner and accessories established to perpetuate locating the position of the corner:

M-5: Replaced iron bolt with 3" Ø concrete monument with Benzie County Remonumentation Program Brass cap. Monument box will be set during road repaving project in 1995.

4" Maple N51°E 74.33'  
8" Maple S40°E 62.16'

14" Maple S64°W 71.13'  
10" Red Pine N43°W 73.22'

Note: All measurements made to double headed nail with brass tag stamped Benzie County Remonumentation Program

Signed by [Signature] Date 12/29/94  
Surveyor's Michigan License No. 30895