

LAND CORNER RECORDATION CERTIFICATE

FILING REQUIREMENT OF ACT 74, MICH. P.A. 1970

FOR CORNERS OF--:	LOCATED IN--:	CORNER CODE NUMBER
1. PUBLIC LAND SURVEY	T. 25 N. R. 14 W.	B-8
2. PROPERTY CONTROLLING IN SECTION 19	T. 25 N. R. 14 W.	2; 12; 15
3. MISCELLANEOUS PROPERTY IN SECTION 19	T. 25 N. R. 14 W. between corner codes 8 & 11, Sec. 19	ZZ = on line & midway
4. LOT NO. _____	RECORDED PLAT _____	
5. PRIVATE CLAIMS _____		

REGISTER OF DEEDS STAMP AND FILING NUMBER

I, Carl F. Roser, do hereby certify that under requirements of P.A. 74, Michigan P.A. of 1970, the corner points mentioned in lines 1 and 2 above were, in a field survey on August 18, 1975, established, re-established, monumented, re-monumented, recovered or restored as expressed below and in conformance with regulations and rules therefore as required in the current manual of survey instructions of the United States Department of the Interior, Bureau of Land Management or by a decree of a court of law. Furthermore, that the corner points mentioned in lines 3, 4 and 5 above were, in a field survey on August 14, 1975, found, recovered, restored, established or re-established as expressed below and in conformance with the rules of the Michigan State Board of Registration for Land Surveyors or, by a Decree of a Court of law:

A. Description of original monument and accessories and/or subsequent restorations:

<p>C. (continued)</p> <p style="text-align: center;">15</p> <ul style="list-style-type: none"> Set 1 1/4" x 36" pipe & ced. post w/loc. tag 8" Maple S50°E 9.1 12" Twn. B. Cherry S50°W 12.4 7" B. Cherry N30°W 10.3 Fd. old 2" pipe N26°20'E 7.0 	<p style="text-align: center;">ZZ</p> <ul style="list-style-type: none"> Drove 1 1/4" x 90" pipe in edge of river Set ced. post w/loc. tag Due S 10' 9" Cedar S22°W 54.1 12" Cedar S14°E 36.0 8" Cedar S35°E 52.7 on rand. N-S & on true line west in south edge of Betsie River
--	--

B. Description of corner evidence found and/or method applied in restoring or re-establishing corner:

B-8 Monumented ctr. of Sec. 19 prorated to H. Bruning survey of Sec. 19; comp. position by holding straight line between fd. N&S 1/4 corners and at prorated dist. to H.R.B. on N-S 1/4 line. Corner falls in westerly edge of stream.

2 Accepted found 1" pipe for 1/16 corner.

12 Found and accepted H. Bruning 1" pipe for S-1/16 corner on N-S 1/4 line.

15 Established W-1/16 corner on south line of Sec. 19 prorated to G.L.O. plat.

ZZ Established NE corner of S 1/2 of frl. NW 1/4 of frl. SW 1/4 of Sec. 19 per G.L.O. plat. Corner falls in S'y edge of Betsie River.

C. Description of monument for corner and accessories established to perpetuate locating the position of the corner:

<p style="text-align: center;">B-8</p> <ul style="list-style-type: none"> Set 1 1/4" x 90" pipe & ced. post w/loc. tag 10" Cedar N55°W 40.8 10" Hemlock S63°W 43.2 7" Hemlock S22°W 65.8 Fd. old 4" x 4" post Due N 4.0' 	<p style="text-align: center;">2</p> <ul style="list-style-type: none"> Found 1" pipe 12" BCherry S23°W 40.0 6" BCherry N09°W 57.2 5" J. Pine N36°E 56.6 Ced. post w/loc. tag Due S 33' Ctr. E-W dirt rd. Due N 3' 	<p style="text-align: center;">12</p> <ul style="list-style-type: none"> Fd. 1" pipe set ced. post w/loc. tag 16" BCherry S38°E 32.0 6" Maple N67°E 19.0 6" Maple S59°W 41.7 HB "T" iron N00°01'E 267.5 HB "T" iron S00°02'W 254.8 Ctr. N-S dirt trail Due W 7'
---	--	--


SIGNED BY Carl F. Roser 3-16-76 DATE _____

SURVEYOR'S MICHIGAN REGISTRATION NO. 12028

FOR STATE AND UNITED STATES AGENCIES:

SIGNED BY _____ DATE _____

APPROVED AND SIGNED BY _____ DATE _____

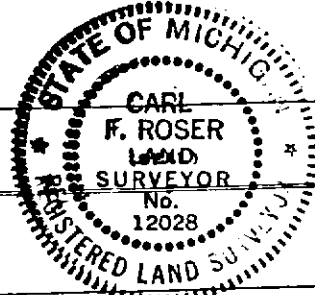

SURVEYOR'S MICHIGAN REGISTRATION NO. _____ WELDON TOWNSHIP
BENZIE COUNTY

FORM APPROVED BY MICHIGAN STATE BOARD OF REGISTRATION, JAN. 26, 1971
REVISED MAY 14, 1975

MAY PLACE SKETCH ON BACK OR ATTACHED SHEET