

MAR 2 2000

LAND CORNER RECORDATION CERTIFICATE LIBER 2 PAGE 300

Filing Requirement of Act 74, Mich. PA 1970

SECTION

For Corners In: BENZIE (County) Located In Corner Code #

Table with 4 columns: Item, T, R, Corner Code #. Includes Public Land Survey, Property Controlling in Section, and Miscellaneous Property in Section.

4. Lot No: Recorded Plat:

5. Private Claims:


I, John B. SmendzuiK in a field survey on November 23, 1999 do hereby state that under requirements of PA 74, Michigan PA of 1970, the corner points mentioned in lines 1 and 2 above were in conformance with regulations and rules therefore as required in the current manual of survey instructions of the United States Department of the Interior, Bureau of Land Management or by a decree of a Court of Law and/or that the corner points mentioned in lines 3, 4 and 5 above were in conformance with the rules of the Michigan Board of Land Surveyors or by a Decree of a Court of Law; established, re-established, monumented, recovered, found as expressed below:

NOTE: Not more than 2 corners, all in the same town and range, may be recorded on this certificate.

STATE OF MICHIGAN BENZIE COUNTY RECORDED


1 FEB 2000 1:52:01 PM MICHELLE R. GRAY REGISTER OF DEEDS # PAGES ONE

Register of Deeds Stamp & File Number

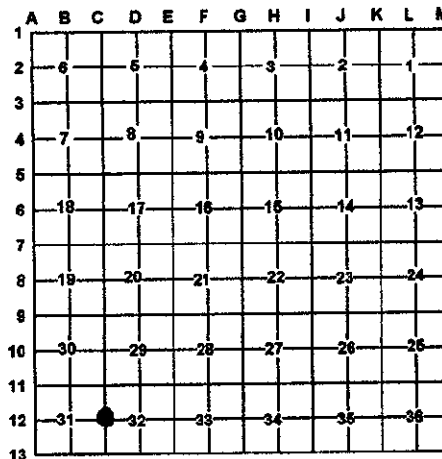

A. Description of original monument and accessories and/or subsequent restoration:

1838: GLO set post and witnesses - 24 Maple S27°E 19 links and 20° Maple N11°W 42 links. 1911: Frank S. Haswell, Survey Records II, Page 114, says he planted a 1" Iron pipe, 4' long from the original witnesses and old stake in a square hole filled with black dirt. 1988: Unrecorded Certificate of Survey by Max Harris shows he found a 1/2" iron rod at this position.

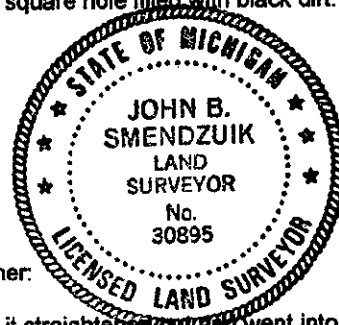

B. Description of corner evidence found and/or method applies in restoring or re-establishing corner:

1999: Found 1/2" X 16" iron rod over top of bent part of 1" iron pipe. Dug up rest of iron pipe and it straightened out and went into the ground straight 3'. Total length of iron pipe was 4'. Found square hole of black dirt and some remains of a wood stake at the bottom of the bent 4' long iron pipe. The Benzie County Peer Group accepted the straight part of the bent iron pipe as the best evidence of the perpetuation of the original GLO corner.

C. Description of monument for corner and accessories established to perpetuate locating the position of the corner:

Removed the 1" iron pipe and set a standard 3" diameter Benzie County Remonumentation Program concrete monument with a brass cap, 5" below the grade of the existing gravel road.

- 13" W. Pine S70°E 26.89' to a set nail and BCRP tag.
14" W. Pine East 49.80' to a set nail and BCRP tag.
12" Red Pine S40°E 40.18' to a set nail and BCRP tag.
8" W. Pine N49°E 33.54' to a set nail and BCRP tag.

Corner is 5' East of the centerline of Long Street.

Ratified by Peer Group In accordance with P.A. 345 Chairman [Signature] Date 11/2/99

Signed by: [Signature] Surveyor's Michigan License No.: 30895

Date: 1/31/2000