

LAND CORNER RECORDATION CERTIFICATE

Filing Requirement of Act 74, Mich. PA 1970

SECTION

| For Corners In: BENZIE (County) | Located In | Corner Code # |
|---------------------------------------|-------------------------|---------------|
| 1. Public Land Survey | T 25N R 14W | E-11 |
| 2. Property Controlling in Section | T _____ R _____ | _____ |
| 3. Miscellaneous Property in Section | S _____ T _____ R _____ | _____ |
| | S _____ T _____ R _____ | _____ |

STATE OF MICHIGAN
BENZIE COUNTY
RECORDED

1 FEB 2000 1:51:24 PM
MICHELLE R. GRAY
REGISTER OF DEEDS
PAGES ONE


Register of Deeds Stamp & File Number

4. Lot No: _____ Recorded Plat: _____

5. Private Claims: _____


I, John B. Smendzuik in a field survey on November 11, 1999, do hereby state that under requirements of PA 74, Michigan PA of 1970, the corner points mentioned in lines 1 and 2 above were in conformance with regulations and rules therefore as required in the current manual of survey instructions of the United States Department of the Interior, Bureau of Land Management or by a decree of a Court of Law and/or that the corner points mentioned in lines 3, 4 and 5 above were in conformance with the rules of the Michigan Board of Land Surveyors or by a Decree of a Court of Law, established, re-established, monumented, recovered, found as expressed below:

NOTE: Not more than 2 corners, all in the same town and range, may be recorded on this certificate.

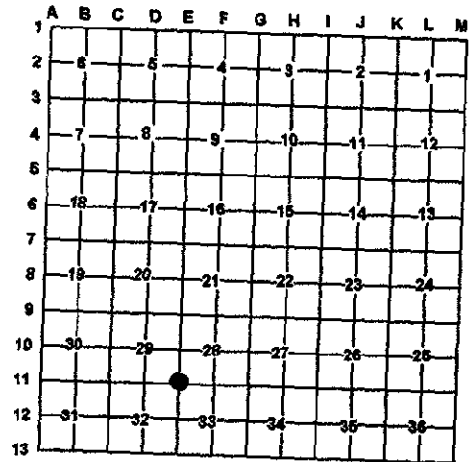

A. Description of original monument and accessories and/or subsequent restoration:

1838: GLO set post and witnesses - 15" Beech S80°E 15 links and 18 Sugar N26°W 30 links. 1911: Frank Haswell, Survey Record II, Page 112 and 114, shows break of all of Section 32 with numbers. Also shows he drove a 1" x 4' long iron pipe from original witness and old stake. 1990: Richard Wilcox, LCRC, recorded in Liber 1, Page 263, shows he found and accepted a 1" iron pipe as a witness.

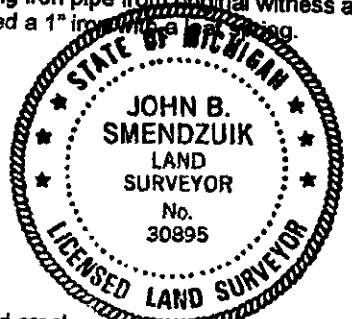

B. Description of corner evidence found and/or method applies in restoring or re-establishing corner:

1999: Found a 1"x 48" iron pipe on East edge of dirt 2 track fitting 2 of Wilcox's witnesses. Also found crockery, glass stones on the West side and a bottle bottom in the bottom of the hole. Also found pieces of scrap metal in the hole. Found no leaf spring as mentioned by Wilcox. The Benzie County Peer Group accepted the 1" iron pipe as the best available evidence of the perpetuation of the original GLO corner.

Ratified by Peer Group
In accordance with P.A. 345
Chairman: John B. Smendzuik
Date: 11/2/99

C. Description of monument for corner and accessories established to perpetuate locating the position of the corner:

Set a standard 3" diameter Benzie County Remonumentation Program concrete monument with a brass cap 5" below the grade of the existing dirt 2 track. Also put all of the crockery, glass and stones found back into the hole.

- Double 17 and 24" Cherry N79°W 105.05' to a found 60D spike.
- 9" Red Pine N40°W 125.68' to a found 60D spike.
- 10" Red Pine N33°E 108.47' to a set nail and BCRP tag.
- 11" Red Pine N56°E 54.20' to a set nail and BCRP tag.

Corner is on the East edge of an existing north-south dirt 2 track and approximately 33' South of the intersection of the north-south 2 track with a 2 track running NW-SE.

Signed by: John B. Smendzuik
Surveyor's Michigan License No.: 30895

Date: 1/31/2000