

APR 07 1998

SECTION

LAND CORNER RECORDATION CERTIFICATE

Filing Requirement of Act 74, Mich. P.A. 1970

STATE OF MICHIGAN
BENZIE COUNTY
RECORDED

19 Jan 1998 9:33:21 AM
MICHELLE R. GRAY
REGISTER OF DEEDS
PAGES one

Register of Deeds Stamp & File Number

For corners in

Benzie
(County)

Located In:

Corner Code #

- 1. Public Land Survey T 25 R 14W G-9
- T _____ R _____
- T _____ R _____
- T _____ R _____
- 2. Property Controlling S _____ T _____ R _____
- in Section S _____ T _____ R _____
- 3. Miscellaneous S _____ T _____ R _____
- Property in Sec. S _____ T _____ R _____

- 4. Lot No. _____, Recorded Plat _____
- 5. Private Claims _____

	A	B	C	D	E	F	G	H	I	J	K	L	M
2	6	5	4	3	2	1							
3													
4	7	8	9	10	11	12							
5													
6	18	17	16	15	14	13							
7													
8	19	20	21	22	23	24							
9													
10	30	29	28	27	26	25							
11													
12	31	32	33	34	35	36							
13													

I, John B. Smendzuik in a field survey on December 15 1997 do hereby certify that under requirements of P.A. 74, Michigan P.A. of 1970, the corner points mentioned in lines 1 and 2 above were in conformance with regulations and rules therefore as required in the current manual of survey instructions of the United States Department of the Interior, Bureau of Land Management or by a decree of a Court of Law and/or that the corner points mentioned in lines 3, 4 and 5 above were in conformance with the rules of the Michigan Board of Land Surveyors or by a Decree of a Court of Law; established, re-established, monumented, re-monumented, recovered, found as expressed below:


NOTE: Not more than 4 corners, all in the same town and range, may be recorded on this certificate.

A. Description of original monument and accessories and/or subsequent restoration:

G-9: 1838: GLO set post - Elm 30" S85°W 36 links and Sugar 9" S70°E 19 links. 1898: James A. Pettit, Surveyor's Record No. 1, Page 202, shows set post by original bearing trees. Undated: Frank S. Haswell, Surveyor's Record No. 2, Page 118, show planted 1" iron pipe, 4' long in square hole filled with top dirt, set from original wits and old stake. 1967: BCRC notes show found 1 1/4" iron pipe found and takes witnesses.

B. Description of corner evidence found and/or method applied in restoring or reestablishing corner:

G-9: 1997: Found 11" of 5/8 rod, threaded on one end (6" below grade of gravel road) over 1" x 4' iron pipe by Haswell (15" below grade), with a 3/4" by 2' iron pipe along side of 4' iron pipe. Also found pieces of plate, glass and old glass electric conductor along side of pipe. The Benzie County Peer Group accepted the 1" x 4' iron pipe as the perpetuation of the GLO corner.

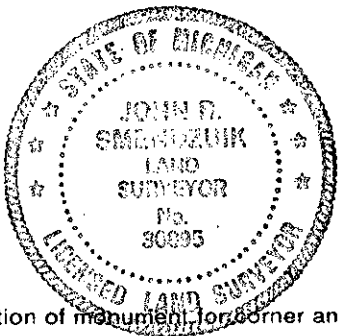

Ratified by Peer Group
In accordance with P.A. 345
Chairman [Signature]
Date 12/10/97

C. Description of monument for corner and accessories established to perpetuate locating the position of the corner:

G-9: Removed the 5/8" rod, the 1" x 4' iron pipe and the 3/4" x 2' iron pipe and set a 3" diameter Benzie County Remonumentation Program concrete monument with a brass cap, 4" below the grade of the gravel road.

- 12" Red Pine S40°W 48.41' to found nail and tag.
- 30" Maple S71°E 105.08' to found nail and tag.
- Power Pole N66°E 105.34' to set BCRP tag and nail.
- 12" Cedar S24°E 53.54' to found nail and tag.
- Concrete monument is in the centerline of the road to the west and in the extension of the road to the north.

Signed by [Signature] Date 1/18/98
Surveyor's Michigan License No. 30895