

LAND CORNER RECORDATION CERTIFICATE

Filing Requirement of Act 74, Mich. P.A. 1970

For corners in

<u>Benzie</u> (County)	Located In:	Corner Code #/
1. Public Land Survey	T <u>25N</u> R <u>14W</u>	<u>G-12</u>
	T _____ R _____	_____
	T _____ R _____	_____
	T _____ R _____	_____
2. Property Controlling in Section	S _____ T _____ R _____	_____
	S _____ T _____ R _____	_____
3. Miscellaneous Property in Sec.	S _____ T _____ R _____	_____
	S _____ T _____ R _____	_____

STATE OF MICHIGAN  
BENZIE COUNTY  
RECORDED

19 Jan 1998 9:34:25 AM  
MICHELLE R. GRAY  
REGISTER OF DEEDS  
# PAGES one

Register of Deeds Stamp & File Number

- 4. Lot No. \_\_\_\_\_, Recorded Plat \_\_\_\_\_
- 5. Private Claims \_\_\_\_\_

A	B	C	D	E	F	G	H	I	J	K	L	M
2	6	5	4	3	2	1						
3												
4	7	8	9	10	11	12						
5												
6	18	17	16	15	14	13						
7												
8	19	20	21	22	23	24						
9												
10	30	29	28	27	26	25						
11												
12	31	32	33	34	35	36						

I, John B. Smendzuik, in a field survey on January 7, 1998, do hereby certify that under requirements of P.A. 74, Michigan P.A. of 1970, the corner points mentioned in lines 1 and 2 above were in conformance with regulations and rules therefore as required in the current manual of survey instructions of the United States Department of the Interior, Bureau of Land Management or by a decree of a Court of Law and/or that the corner points mentioned in lines 3, 4 and 5 above were in conformance with the rules of the Michigan Board of Land Surveyors or by a Decree of a Court of Law; established, re-established, monumented, re-monumented, recovered, found as expressed below:

NOTE: Not more than 4 corners, all in the same town and range, may be recorded on this certificate.


A. Description of original monument and accessories and/or subsequent restoration:  
G-12: 1838: GLO set post - Beech 15" S67°E 19 links and Beech 8" N31°W 11 links. Undated: Frank S. Haswell, Surveyor's Record 2, Page 112, says drove a 1" x 4' long iron pipe from original witnesses and old stake. 1965: Harold R. Bruning notes show he found a 1" iron pipe at this corner. 1990: Richard D. Wilcox in a Certificate of Survey recorded in Liber 2 of Surveys, page 116, and in a LCRC recorded in Liber 1, Page 263, he shows a found 1" iron pipe and has witnesses to it.

B. Description of corner evidence found and/or method applied in restoring or reestablishing corner:  
G-12: 1997: Found 1" x 4' iron pipe set by Haswell and found by Wilcox. The Benzie County Peer Group accepted the iron pipe as the perpetuation of the original GLO corner.

Ratified by Peer Group  
In accordance with P.A. 345  
Chairman [Signature]  
Date 12/10/97

C. Description of monument for corner and accessories established to perpetuate locating the position of the corner:  
G-12: Removed the 1" iron pipe and set a 3" diameter Benzie County Remonumentation Program concrete monument with a brass cap.

- 16" Beech N17°E 10.10' to found 60D spike.
- 24" Triple Maple N80°W 24.08' to found 60D spike.
- 17" Beech S42°W 19.56' to found 60D spike.
- 13" Oak S54°E 46.41' to found 60D spike.
- All witness trees are from Wilcox work. Corner is approximately 75' North of ski trail.

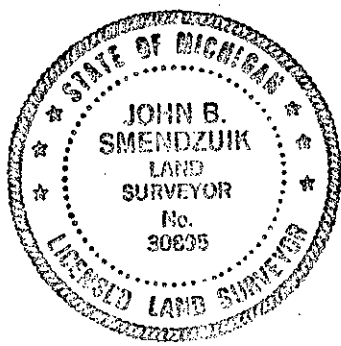

Signed by [Signature] Date 1/18/98  
Surveyor's Michigan License No. 30895