

APR 07 1998

LIBER 2 PAGE 114

LAND CORNER RECORDATION CERTIFICATE

Filing Requirement of Act 74, Mich. P.A. 1970

STATE OF MICHIGAN
BENZIE COUNTY
RECORDED

19 Jan 1998 9:33:08 AM
MICHELLE R. GRAY
REGISTER OF DEEDS
PAGES one

Register of Deeds Stamp & File Number

For corners in SECTION

Benzie
(County)

Located In:

Corner Code #

- 1. Public Land Survey T 25N R 14W H-9
T _____ R _____
T _____ R _____
T _____ R _____
- 2. Property Controlling S _____ T _____ R _____
in Section S _____ T _____ R _____
- 3. Miscellaneous S _____ T _____ R _____
Property in Sec. S _____ T _____ R _____

- 4. Lot No. _____, Recorded Plat _____
- 5. Private Claims _____

	A	B	C	D	E	F	G	H	I	J	K	L	M
2	6		5		4		3		2		1		
3													
4	7		8		9		10		11		12		
5													
6	16		17		16		15		14		13		
7													
8	19		20		21		22		23		24		
9													
10	30		29		28		27		26		25		
11													
12	31		32		33		34		35		36		
13													

I, John B. Smendzuik, in a field survey on December 15, 19 97, do hereby certify that under requirements of P.A. 74, Michigan P.A. of 1970, the corner points mentioned in lines 1 and 2 above were in conformance with regulations and rules therefore as required in the current manual of survey instructions of the United States Department of the Interior, Bureau of Land Management or by a decree of a Court of Law and/or that the corner points mentioned in lines 3, 4 and 5 above were in conformance with the rules of the Michigan Board of Land Surveyors or by a Decree of a Court of Law; established, re-established, monumented, re-monumented, recovered, found as expressed below:


NOTE: Not more than 4 corners, all in the same town and range, may be recorded on this certificate.

A. Description of original monument and accessories and/or subsequent restoration:

H-9: 1838: GLO set post - Beech 10" N65°E 21 links and Beech 10" S30°W 28 links. 1898: James A. Pettit, Surveyor's Record No. 1, Page 202, shows cedar post and distances to east, south and west. 1904: E. P. Waterman notes show stake at corner and distance to south. 1967: BCRC notes show found 1 1/4" iron pipe found and takes witnesses. 1972: BCRC places cast iron county marker over old pipe. Checks old witnesses and shows 1 gone.

B. Description of corner evidence found and/or method applied in restoring or reestablishing corner:

H-9: 1997: Found 19" of Benzie County cast iron Harrison marker at road surface over a 1/2" x 1' iron pipe over an iron pipe +4' below road grade. The Benzie County Peer Group accepted the Benzie County cast iron Harrison marker as the perpetuation of a locally accepted corner.

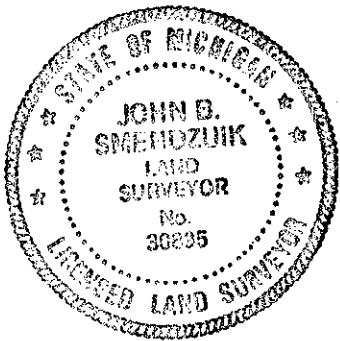

Ratified by Peer Group
In accordance with P.A. 345
Chairman [Signature]
Date 12/10/97

C. Description of monument for corner and accessories established to perpetuate locating the position of the corner:

H-9: Removed the Harrison marker and the 1/2" x 1' iron pipe and set a 3" diameter Benzie County Remonumentation Program concrete monument with a brass cap, over the iron +4' below grade, in a monument box.

- 9" Red Pine N27°E 52.84' to found nail and tag.
- 20" Maple N06°E 73.46' to found nail and tag. (BCRC witness)
- 10" Maple S48°E 57.80' to found 60D spike.
- 15" Maple S34°E 57.26' to found 60D spike.
- Monument box is 3.5' south of the centerline of the east-west road. (Pioneer Road - Co. Rd. 677)

Signed by [Signature]
Surveyor's Michigan License No. 30895

Date 1/18/98