

APR 07 1998

SECTION

LIBER 2 PAGE 117

LAND CORNER RECORDATION CERTIFICATE
Filing Requirement of Act 74, Mich. P.A. 1970

For corners in

STATE OF MICHIGAN
 BENZIE COUNTY
 RECORDED

<u>Benzie</u> (County)	Located In:	Corner Code #:
1. Public Land Survey	T <u>25N</u> R <u>14W</u>	<u>K-11</u>
	T _____ R _____	_____
	T _____ R _____	_____
	T _____ R _____	_____
2. Property Controlling in Section	S _____ T _____ R _____	_____
	S _____ T _____ R _____	_____
3. Miscellaneous Property in Sec.	S _____ T _____ R _____	_____
	S _____ T _____ R _____	_____
4. Lot No. _____, Recorded Plat _____		
5. Private Claims _____		

19 Jan 1998 9:33:46 AM
 MICHELLE R. GRAY
 REGISTER OF DEEDS
 # PAGES one

Register of Deeds Stamp & File Number

A	B	C	D	E	F	G	H	I	J	K	L	M
2	6	5	4	3	2	1						
3												
4	7	8	9	10	11	12						
5												
6	18	17	16	15	14	13						
7												
8	19	20	21	22	23	24						
9												
10	30	29	28	27	26	25						
11												
12	31	32	33	34	35	36						
13												

I, John B. Smendzuik, in a field survey on December 21, 19 97, do hereby certify that under requirements of P.A. 74, Michigan P.A. of 1970, the corner points mentioned in lines 1 and 2 above were in conformance with regulations and rules therefore as required in the current manual of survey instructions of the United States Department of the Interior, Bureau of Land Management or by a decree of a Court of Law and/or that the corner points mentioned in lines 3, 4 and 5 above were in conformance with the rules of the Michigan Board of Land Surveyors or by a Decree of a Court of Law; established, re-established, monumented, re-monumented, recovered, found as expressed below:

NOTE: Not more than 4 corners, all in the same town and range, may be recorded on this certificate.


A. Description of original monument and accessories and/or subsequent restoration:
 K-11: 1838: GLO set post - Sugar 15" N74°W 14 links and Hemlock 11" S83°E 20 links. Undated: James A. Pettit, Surveyor's Record No. 2, Page 30, found gas pipe and stumps of original bearing trees. Undated 1905 (approx.): Guy Langford, Surveyor's Record 2, Page 40, found gas pipe. 1971: Harold R. Bruning notes show he found a 1" pipe at this location. 1975: BCRC notes found 1" iron pipe found and takes witnesses. 1988: James Ray in a Certificate of Survey recorded in Liber 2, Page 958, shows a found 1" iron pipe and takes witnesses.

B. Description of corner evidence found and/or method applied in restoring or reestablishing corner:
 K-11: 1997: Found 1/2" x 18" iron over bent 1" x 5' galvanized iron pipe at old BCRC and Bruning witnesses. The Benzie County Peer Group accepted the iron pipe as the perpetuation of the GLO corner.

Ratified by Peer Group
 In accordance with P.A. 345
 Chairman John B. Smendzuik
 Date 12/10/97

C. Description of monument for corner and accessories established to perpetuate locating the position of the corner:
 K-11: Removed the 1/2" x 18" iron, and the 1" iron pipe and set a 3" diameter Benzie County Remonumentation Program concrete monument with a brass cap 6" below grade of gravel road.

- 9" Twin Maple N45°E 55.50' to found nail and blaze. (BCRC witness).
- 12" Maple N87°E 46.10' to found nail and blaze. (BCRC witness).
- 18" Maple N38°W 41.91' to set BCRP nail and tag.
- Concrete monument West 33.00'.
- Power Pole S58°W 40.33' to pk nail in a tag.
- Corner is on East edge of an existing gravel road. (Haze Road)

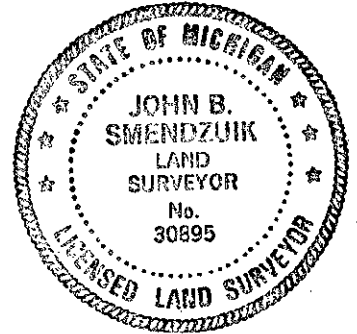

Signed by John B. Smendzuik Date 1/18/98
 Surveyor's Michigan License No. 30895