

LAND CORNER RECORDATION CERTIFICATE

Filing Requirement of Act 74, Mich. PA 1970

STATE OF MICHIGAN  
BENZIE COUNTY  
RECORDED

1 FEB 2000 1:49:31 PM  
NICHELLE R. GRAY  
REGISTER OF DEEDS  
# PAGES ONE

Register of Deeds Stamp & File Number

SECTION  
For Corners In  
BENZIE  
(County)

Located In Corner Code #

1. Public Land Survey	T	25N	R	14W	K-12
	T		R		
2. Property Controlling in Section	S	T	R		
	S	T	R		
3. Miscellaneous Property in Section	S	T	R		
	S	T	R		

4. Lot No: \_\_\_\_\_ Recorded Plat: \_\_\_\_\_

5. Private Claims: \_\_\_\_\_

I, John B. Smendzuik in a field survey on November 11, 1999, do hereby state that under requirements of PA 74, Michigan PA of 1970, the corner points mentioned in lines 1 and 2 above were in conformance with regulations and rules therefore as required in the current manual of survey instructions of the United States Department of the Interior, Bureau of Land Management or by a decree of a Court of Law and/or that the corner points mentioned in lines 3, 4 and 5 above were in conformance with the rules of the Michigan Board of Land Surveyors or by a Decree of a Court of Law, established, re-established, monumented, recovered, found as expressed below:

NOTE: Not more than 2 corners, all in the same town and range, may be recorded on this certificate.

A	B	C	D	E	F	G	H	I	J	K	L	M
1												
2	6	5	4	3	2	1						
3												
4	7	8	9	10	11	12						
5												
6	18	17	16	15	14	13						
7												
8	19	20	21	22	23	24						
9												
10	30	29	28	27	26	25						
11												
12	31	32	33	34	35	36						
13												

A. Description of original monument and accessories and/or subsequent restoration:

1838: GLO set post and witnesses - 12" Sugar N71°E 20 links and 16" Beech S58°W 38 links. Undated: Guy Langford, Survey Record II, Page 40, says original corner stone by E. Bundy, (E. Bundy was a landowner in section 36 and worked on Langford's crew to split this section). 1961 Harold Bruning note show distances to fence to the North. Undated: BCRC found a 1 1/4" rod in monument box. 1985: Harold Bruning found a 1" iron bar. 1988: Jim Ray of Wade Trim Granger in a Certificate of Survey in Liber 1, Page 958 shows he found a 1 1/2" iron bar

B. Description of corner evidence found and/or method applies in restoring or re-establishing corner:

1999: Found 1 1/4" X 39" iron bar, 10" below grade next to a column of wood stake remains. Also found 2 - 29" long irons with square bolts on top and a 3/4" iron bar around the first iron bar at varying depths in the ground. The column of wood remains ran to 48" below grade. The corner is in the intersection of Haze and Lindy Roads. The Benzie County Peer Group accepted the iron pipe as the best evidence of the perpetuation of the original GLO corner.

Ratified by Peer Group  
In accordance with P.A. 345

Chairman [Signature]


Date 11/2/99

C. Description of monument for corner and accessories established to perpetuate locating the position of the corner:

Removed the 1 1/4" iron pipe and all other irons and set a standard 3" diameter Benzie County Remonumentation Program concrete monument with a brass cap in a monument box.

- 13" Red Pine N43°W 64.27' to a set new nail and BCRP tag.
- 15" Red Pine N28°W 53.90' to a set new nail and BCRP tag.
- 12" Jack Pine S61°E 90.41' to set nail and BCRP tag.
- 13" Ironwood S76°W 97.25' to set nail and BCRP tag.

Corner is in centerline of Haze Road and 2' South of the centerline of Lindy Road (Co. Rd. 602)

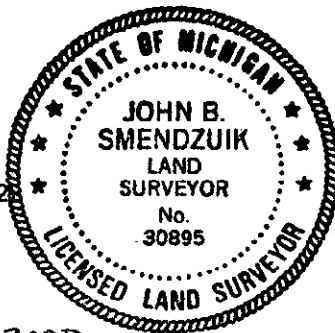

Signed by: [Signature]

Date: 1/31/2000

Surveyor's Michigan License No.: 30895