

**SURVEY &
REMONUMENTATION**

MAY - 1 1995

COMMISSION

LAND CORNER RECORDATION CERTIFICATE
Filing Requirement of Act 74, Mich. P.A. 1970

LIBER 2 PAGE 35

For corners in

<u>Benzie</u> <small>(County)</small>	Located In:	Corner Code <u>M-4</u>
1. Public Land Survey	T <u>25N</u> R <u>14W</u>	<u>M-4</u>
	T _____ R _____	_____
	T _____ R _____	_____
	T _____ R _____	_____
2. Property Controlling in Section	S _____ T _____ R _____	_____
	S _____ T _____ R _____	_____
3. Miscellaneous Property in Sec.	S _____ T _____ R _____	_____
	S _____ T _____ R _____	_____
4. Lot No. _____, Recorded Plat _____		
5. Private Claims _____		

STATE OF MICHIGAN
BENZIE COUNTY
RECORDED

29 DEC 94 4:43 P.M.

MICHELLE R. GRAY
REGISTER OF DEEDS

Register of Deeds Stamp & File Number

I, John B. Smendzuik, in a field survey on December 16 and 23, 1994, do hereby certify that under requirements of P.A. 74, Michigan P.A. of 1970, the corner points mentioned in lines 1 and 2 above were in conformance with regulations and rules therefore as required in the current manual of survey instructions of the United States Department of the Interior, Bureau of Land Management or by a decree of a Court of Law and/or that the corner points mentioned in lines 3, 4 and 5 above were in conformance with the rules of the Michigan Board of Land Surveyors or by a Decree of a Court of Law; established, re-established, monumented, re-monumented, recovered, found as expressed below:

NOTE: Not more than 4 corners, all in the same town and range, may be recorded on this certificate.

	A	B	C	D	E	F	G	H	I	J	K	L	M
2	6	5	4	3	2	1							
3													
4	7	8	9	10	11	12							
5													
6	18	17	16	15	14	13							
7													
8	19	20	21	22	23	24							
9													
10	30	29	28	27	26	25							
11													
12	31	32	33	34	35	36							
13													


A. Description of original monument and accessories and/or subsequent restoration:

M-4: G.L.O. set post - 12" Beech S52°W 19.80'. 11" Hemlock N49°W 12.54'. 1869 - George Steele, Surveyor's Record I, Page 94, reset from original trees. James Pettit, Surveyor's Record II, Page 8, set post equidistant between adjacent section corners. 1979 - Bill Batzer found 1" pipe doing section survey. 1982 - B.C.R.C. found 2" pipe. May 1984 - B.C.R.C. - raised with 18" of 3/8" rerod.

B. Description of corner evidence found and/or method applied in restoring or reestablishing corner:

M-4: Found 1 1/4" (I.D.) x 29" iron pipe with 3/8" rod in top of it, per B.C.R.C. Records, approximately 17" below existing road grade.

Ratified by Peer Group
In accordance with P.A. 345
Chairman [Signature]
Date 12/19/94

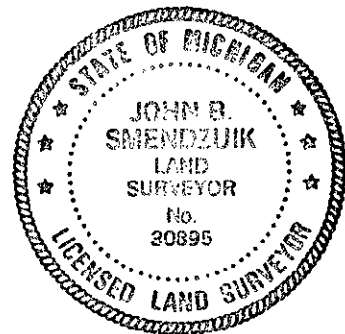

C. Description of monument for corner and accessories established to perpetuate locating the position of the corner:

M-4: Pulled iron pipe and set 3" Ø concrete monument with Benzie County Remonumentation Program Brass cap. Monument box to be set in 1995 when repaving project is complete.
12" Red Pine with blaze N60°W 53.59'
10" Red Pine with blaze N50°E 69.81'
10" Red Pine with blaze S69°W 34.60'
12" Red Pine with blaze S40°E 46.86'

Note: All measurements made to double headed nail with brass tag stamped Benzie County Remonumentation Program

Signed by [Signature] Date 12/29/94
Surveyor's Michigan License No. 30895