


LAND CORNER RECORDATION CERTIFICATE

Filing Requirement of Act 74, Mich. PA 1970

For Corners In: Benzie (County)	Located In	Corner Code #	
1. Public Land Survey	T <u>25N</u> R <u>14W</u>	<u>K10</u>	
	T _____ R _____	_____	
2. Property Controlling in Section	S _____ T _____ R _____	_____	
	S _____ T _____ R _____	_____	
3. Miscellaneous Property in Section	S _____ T _____ R _____	_____	
	S _____ T _____ R _____	_____	
4. Lot No: _____	Recorded Plat: _____		
5. Private Claims: _____			

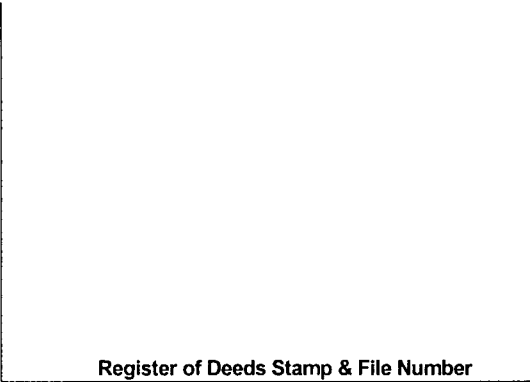

I, Craig W. McVean, in a field survey on Dec. 23, 2002 do hereby state that under requirements of PA 74, Michigan PA of 1970, the corner points mentioned in lines 1 and 2 above were in conformance with regulations and rules therefore as required in the current manual of survey instructions of the United States Department of the Interior, Bureau of Land Management or by a decree of a Court of Law and/or that the corner points mentioned in lines 3, 4 and 5 above were in conformance with the rules of the Michigan Board of Land Surveyors or by a Decree of a Court of Law; established, re-established, monumented, recovered, found as expressed below:

NOTE: Not more than 2 corners, all in the same town and range, may be recorded on this certificate.

	A	B	C	D	E	F	G	H	I	J	K	L	M
1													
2	6		5		4		3		2		1		
3													
4	7		8		9		10		11		12		
5													
6	18		17		16		15		14		13		
7													
8	19		20		21		22		23		24		
9													
10	30		29		28		27		26	●	25		
11													
12	31		32		33		34		35		36		
13													

A. Description of original monument and accessories and/or subsequent restoration:


- K10 – GLO – Set ¼ Post – Alvin & Austin Burt – 1838
 - Sugar 12" N25°W 3L.
 - Beech 10" S2°E 13L.
- CSR – L.2, P. 30 – J.A. Pettitt – No Date
 - Sec. 25 Survey. Set monuments on E-W ¼ line but no direct reference to K10.
- H.R. Bruning – Unrecorded Survey & Notes – 1976
 - Set 5/8" Iron rod from physical evidence & occupation. 10" R. Pine N72°E 37.22'; 12" R. Pine East 38.17'
- Rec. Survey – L.2, P. 811 – H.R. Bruning – 1985 - Iron stake Fd.
- LCRC – L.1, P.311 – R.M. Harris – 1994 -
 - 5/8" Iron rod & Cap #10681
 - 6" Cherry N16°W 26.60'; 16" W. Pine N78°E 38.20'; 10" W. Pine N82°W 43.45'; 8" Cherry S14°E 62.30'
- Rec. Survey – L.2, P. 882 – W.A. Papineau – 1997 – Fd. 5/8" iron rod & cap.

B. Description of corner evidence found and/or method applied in restoring or re-establishing corner:

- K10 – ¼ Corner common to Sec. 25 & 26 – Fd. old 1 ¼" I.D. x 2.3' Long iron pipe in line with centerline road S. extended N. & occupation E. Accepted 1 ¼" pipe based on
 - 1) Fits remains of fence line and field furrow line extended from East.
 - 2) 1 ¼" Iron pipe is consistent with monumentation found at other government corners in Section 25.
 - 3) Pipe is nearly midway and on line between section corner N & S as it should be. 1 ¼" iron pipe accepted as the best available evidence of the position of the original corner and is approved as a locally accepted corner.
- Ref. Pt. – Fd. 5/8" Capped Iron rebar #10681 – N8°05'W 13.37' from 'K10'. 5/8" Capped Iron Rod established by Bruning in 1976 but could find no physical evidence or occupation to support this position. Harris LCRC & Rec. Surveys in 1985 & 1997 note this 5/8" Capped Iron Rod. 5/8" Capped Iron Rod #10681 not utilized as 'K10' in this survey.

C. Description of monument for corner and accessories established to perpetuate locating the position of the corner:

- K10 – Replaced 1 ¼" I.D. x 2.3' Long Iron Pipe with 3" Benzie Co. Remon. Brass Cap on ¼" Iron Pipe encased in 4" x 36" Conc. Cylinder – Down 0.5'.
 - Centerline of 2-track on curve is 10' East.
 - West 16.5' to Set Blue Carsonite Post with location tag.
 - N80°E 36.44' to Set N&T in South side 17" R. Pine
 - N30°W 55.46' to Set N&T in East side 10" R. Pine scribed 'XBT'
 - N78°W 38.25' to Set N&T in South side 12" R. Pine scribed 'XBT'
 - S43°W 41.22' to Set N&T in Northwest side 11" R. Pine scribed 'XBT'
 - N8° 05'W 13.37' to Fd. 5/8" Capped Iron Rod #10681 – Ref. Pt.

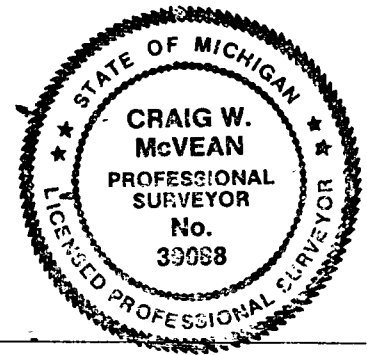

Signed by: Craig W. McVean
 Surveyor's Michigan License No.: 39088

Date: 1/7/2003