

LAND CORNER RECORDATION CERTIFICATE

Filing Requirement of Act 74, Mich. PA 1970

For Corners In:
Benzie Located In _____ Corner Code # _____
 (County)

- | | | | | | |
|--------------------------------------|------------|--------------|--------------|--|------------------|
| 1. Public Land Survey | T _____ | R _____ | | | |
| | T _____ | R _____ | | | |
| 2. Property Controlling in Section | S <u>8</u> | T <u>25N</u> | R <u>14W</u> | | <u>SWNW 1/64</u> |
| | S <u>8</u> | T <u>25N</u> | R <u>14W</u> | | <u>CSNW 1/64</u> |
| 3. Miscellaneous Property in Section | S _____ | T _____ | R _____ | | |
| | S _____ | T _____ | R _____ | | |


Register of Deeds Stamp & File Number

4. Lot No: _____ Recorded Plat: _____

5. Private Claims: _____

I, Craig W. McVean, in a field survey on May 20, 2009 do hereby state that under requirements of PA 74, Michigan PA of 1970, the corner points mentioned in lines 1 and 2 above were in conformance with regulations and rules therefore as required in the current manual of survey instructions of the United States Department of the Interior, Bureau of Land Management or by a decree of a Court of Law and/or that the corner points mentioned in lines 3, 4 and 5 above were in conformance with the rules of the Michigan Board of Land Surveyors or by a Decree of a Court of Law; established, re-established, monumented, recovered, found as expressed below:

NOTE: Not more than 2 corners, all in the same town and range, may be recorded on this certificate.

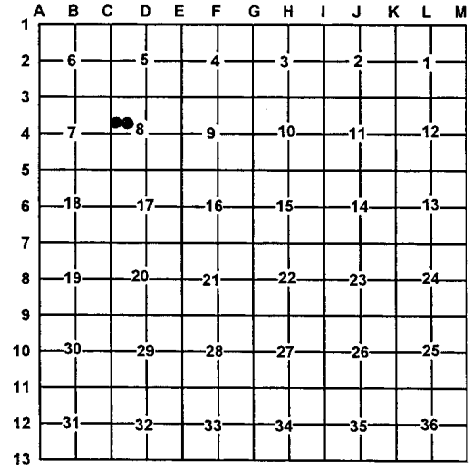

A. Description of original monument and accessories and/or subsequent restoration:

SWNW 1/64 Corner, Sec. 8 - None

CSNW 1/64 Corner, Sec. 8 - None



B. Description of corner evidence found and/or method applied in restoring or re-establishing corner:

SWNW 1/64 Corner, Sec. 8 being the SW Corner of the NE 1/4 of the SW 1/4 of the NW 1/4 of Sec. 8 - Set stamped 2" Aluminum Cap on 5/8" x 34" rebar per Standard BLM procedure.

CSNW 1/64 Corner, Sec. 8 being the SE corner of the NE 1/4 of the SW 1/4 of the NW 1/4 of Sec. 8 - Set Stamped 2" Aluminum cap on 5/8" x 34" rebar midway between platted corners #4 (NW 1/16, Sec. 8) and #8 (CW 1/16, Sec. 8) and on the West line of "Plat of Orchardville No. 4" per L. 2 of plats, p. 46.

C. Description of monument for corner and accessories established to perpetuate locating the position of the corner:

SWNW 1/64 Corner, Sec. 8 - Stamped 2" Aluminum cap on 5/8" x 34" rebar
 N01°E 32.40' to set nail & tag in W. side 6" Red Maple
 S74°E 30.12' to set nail & tag in N. side 10" Cherry
 S03°E 5.27' to set nail & tag in E. side 11" Cherry
 N48°E 35.80' to set nail & tag in NW side 8" Cherry
 Set Blue Carsonite Post with location tag 1' Northeast

CSNW 1/64 Corner, Sec. 8 - Stamped 2" Aluminum cap on 5/8" x 34" rebar
 S60°W 12.63' to set nail & tag in N. side 6" Sugar Maple
 N74°E 10.01' to set nail & tag in S. side 13" White Pine
 S01°52'W 5.79' to found 1" I.D. iron pipe per "Orchardville No. 4"
 N01°52'E 159.49' to found 1" I.D. iron pipe per "Orchardville No. 4"
 Set Blue Carsonite post with location tag 1' Northeast

Signed by: Craig W. McVean Date: 4/21/2010
 Surveyor's Michigan License No.: 39088