

LAND CORNER RECORDATION CERTIFICATE

Filing Requirement of Act 74, Mich. PA 1970

For Corners In:
Benzie Located In _____ Corner Code # _____
 (County)


1. Public Land Survey T 25N R 14W G2
 T _____ R _____

2. Property Controlling in Section S _____ T _____ R _____
 S _____ T _____ R _____

3. Miscellaneous Property in Section S _____ T _____ R _____
 S _____ T _____ R _____

4. Lot No: _____ Recorded Plat: _____

5. Private Claims: _____

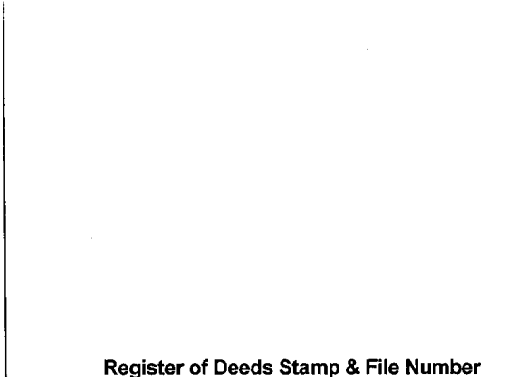

I, Craig W. McVean, in a field survey on Aug. 5, 2009 do hereby state that under requirements of PA 74, Michigan PA of 1970, the corner points mentioned in lines 1 and 2 above were in conformance with regulations and rules therefore as required in the current manual of survey instructions of the United States Department of the Interior, Bureau of Land Management or by a decree of a Court of Law and/or that the corner points mentioned in lines 3, 4 and 5 above were in conformance with the rules of the Michigan Board of Land Surveyors or by a Decree of a Court of Law; established, re-established, monumented, recovered, found as expressed below:

NOTE: Not more than 2 corners, all in the same town and range, may be recorded on this certificate.

| | | | | | | | | | | | | | |
|----|----|---|----|---|---|----|---|----|---|----|---|----|---|
| | A | B | C | D | E | F | G | H | I | J | K | L | M |
| 1 | | | | | | | | | | | | | |
| 2 | 6 | | 5 | | | 4 | ● | 3 | | 2 | | 1 | |
| 3 | | | | | | | | | | | | | |
| 4 | 7 | | 8 | | | 9 | | 10 | | 11 | | 12 | |
| 5 | | | | | | | | | | | | | |
| 6 | 18 | | 17 | | | 16 | | 15 | | 14 | | 13 | |
| 7 | | | | | | | | | | | | | |
| 8 | 19 | | 20 | | | 21 | | 22 | | 23 | | 24 | |
| 9 | | | | | | | | | | | | | |
| 10 | 30 | | 29 | | | 28 | | 27 | | 26 | | 25 | |
| 11 | | | | | | | | | | | | | |
| 12 | 31 | | 32 | | | 33 | | 34 | | 35 | | 36 | |
| 13 | | | | | | | | | | | | | |

A. Description of original monument and accessories and/or subsequent restoration:

- G2 – 1838 – GLO – Alvin & Austin Burt
 Set ¼ Post
 1) Sugar 8" N32½°E 35 L.
 2) Sugar 18" S29°W 30 L.
 - 1865 – Wm. Slawson – Shelly limestone 9" x 15", 3 inches thick standing edgewise, longest North & South 'X' in middle of west side facing an ironwood stake.
 - 1972 – BCRC Notes & Road Survey Co. Rd. #671 – Placed ¼" pipe 12" long
 3) 5" Pine N80°W 57.7'
 4) 6" Pine S45°W 64.98'
 5) Tree S40°E 45.85'

B. Description of corner evidence found and/or method applied in restoring or re-establishing corner:

G2 – ¼ Corner common to Sec. 3 & 4 – Fd. ¾" x 14" long iron pipe – 1' West of centerline of N-S Bit. Rd. Fence remains on ground to West. No GLO evidence. Removed pipe and dug under but no evidence of stone below. Appears this pipe was set to agree with fence occupation. Pipe is close to single proportion position. Do not know if road commission dug here but based on their notes they excavated a number of corners in this road survey. Measured Grid Bearing & distances from 'G2' as follows:
 N2°22'13"E 3079.80' (3036.0' – GLO, 3080.0' – BCRC) to 'G1' and S2°25'21"W 2671.15' (2640' – GLO, 2672.60' – BCRC) to 'G3'.
 ¾" iron pipe accepted as the best evidence of a locally accepted corner.

C. Description of monument for corner and accessories established to perpetuate locating the position of the corner:

G2 – Replaced ¾" x 14" iron pipe with stamped 3" Benzie Co. Remonumentation
 Brass cap on ¾" x 36" iron pipe encased in 4" x 36" concrete cylinder in Monument Box.
 Set Blue Carsonite Post with loc. tag 33' West.
 N43°E 76.31' to set N & T in NW side Tw. 9" and 7" Sugar Maple
 S52°E 45.75' to set N & T in SW side 13" R. Pine (#5)
 S53°W 64.91' to set N & T in N. side 11" R. Pine (#4)
 N70°W 57.59' to set N & T at Fd. N & T in N. side 8" J. Pine (#3)



Signed by: Craig W. McVean Date: 1/7/2010
 Surveyor's Michigan License No.: 39088