

LAND CORNER RECORDATION CERTIFICATE

FILING REQUIREMENT OF ACT 74, MICH. P.A.1970

| FOR CORNERS OF--: | LOCATED IN--: | CORNER CODE NUMBER |
|---------------------------------------|-------------------|--------------------|
| 1. PUBLIC LAND SURVEY | T. 25 N. R. 15 W. | L-1; M-2 |
| 2. PROPERTY CONTROLLING IN SECTION | T. S. R. E. W. | |
| 3. MISCELLANEOUS PROPERTY IN SECTION | T. S. R. E. W. | |
| 4. LOT NO. _____, RECORDED PLAT _____ | | |
| 5. PRIVATE CLAIMS _____ | | |

REGISTER OF DEEDS STAMP AND FILING NUMBER

I, Carl F. Roser, do hereby certify that under requirements of P.A. 74, Michigan P.A. of 1970, the corner points mentioned in lines 1 and 2 above were, in a field survey on Jan. 10, 1979, established, re-established, monumented, re-monumented, recovered or restored as expressed below and in conformance with regulations and rules therefore as required in the current manual of survey instructions of the United States Department of the Interior, Bureau of Land Management or by a decree of a court of law. Furthermore, that the corner points mentioned in lines 3, 4 and 5 above were, in a field survey on _____, 19____, found, recovered, restored, established or re-established as expressed below and in conformance with the rules of the Michigan State Board of Registration for Land Surveyors or, by a Decree of a Court of law:

A. Description of original monument and accessories and/or subsequent restoration:

B. Description of corner evidence found and/or method applied in restoring or re-establishing corner:

- L-1 Fd. 1 1/2" Ir. Rod in B.Top road intersection N-S-E; for N 1/4 Cor. Sec. 1, T25N-R15W. Ctr. of N-S B.Top is 2'+ E. Ctr. of E-W ~~grove/ rd.~~ to E. is 3'+ North. Cor. is in line with fence to West.
- M-2 Fd. 1/4"X4"X18" flat iron & broken bottle (Dr. Kilmer Swamp Root) for 1/4 Cor. to Sec. 1 (T25N-R15W) and Sec. 6 (T25N-R14W). Cor. is in old N-S fence (B-W, down) and in line with old E-W Field berm to east. Corner fits live clump of (4) black cherry (Suckers) for probable evidence of U.S.B.T. remains, N16°W, 19.8'.

C. Description of monument for corner and accessories established to perpetuate locating the position of the corner:

| L-1 | | | M-2 | | |
|---------------------------------|-------|-------|---------------------------|-------|------|
| Fd. 1 1/2" Iron Rod | | | Fd 1/4"X4"X18" flat iron | | |
| 14" Maple | N84°W | 50.37 | added DNR Mon. & Ced.Post | | |
| P.Pole | S62°E | 57.83 | 9" Cherry in clump | N12°W | 18.9 |
| 22" Maple | N69°E | 84.61 | 8" Maple | S17°W | 24.7 |
| Fd. Benzie Co. Mon.- S 1/4 S-36 | | | 11" Maple | S15°E | 27.0 |
| (T26N-R15W) S89°46'W | | 12.58 | Ctr. N-S trail rd. Due E. | | 55'+ |
| Set Ced.Post w/Loc. Tag. | | | | | |
| Due W | | 33' | | | |


SIGNED BY Carl F. Roser 2-12-79 DATE

SURVEYOR'S MICHIGAN REGISTRATION NO. 12028

FOR STATE AND UNITED STATES AGENCIES:

SIGNED BY _____ DATE _____

APPROVED AND SIGNED BY _____ DATE _____

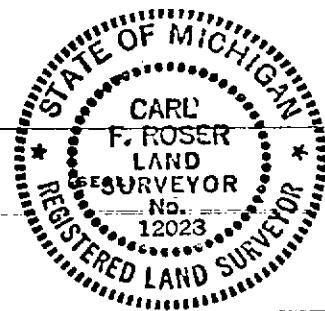

SURVEYOR'S MICHIGAN REGISTRATION NO. _____

BENZIE COUNTY