

LAND CORNER RECORDATION CERTIFICATE

FILING REQUIREMENT OF ACT 74, MICH. P.A.1970

FOR CORNERS OF--:	LOCATED IN--:	CORNER CODE NUMBER
1. PUBLIC LAND SURVEY _____	T. 25 ^{N.} _● R. 15 [●] _{W.}	I-2; J-3
2. PROPERTY CONTROLLING IN SECTION <u>2</u>	, T. 25 ^{N.} _● R. 15 [●] _{W.}	5; 6; 7
3. MISCELLANEOUS PROPERTY IN SECTION _____	, T. _____ ^{N.} _● S. R. _____ [●] _{W.}	
4. LOT NO. _____, RECORDED PLAT _____		
5. PRIVATE CLAIMS _____		

REGISTER OF DEEDS STAMP AND FILING NUMBER

I, Carl F. Roser do hereby certify that under requirements of P.A. 74, Michigan P.A. of 1970, the corner points mentioned in lines 1 and 2 above (identified with circles on index code diagram - over) were, in a field survey on July 29, 1974, established, re-established, monumented, re-monumented, recovered or restored as expressed below and in conformance with regulations and rules therefore as required in the current manual of survey instructions of the United States Department of the Interior, Bureau of Land Management or by a decree of a court of law. Furthermore, that the corner points mentioned in lines 3, 4 and 5 above were, in a field survey on _____ 19____, found, recovered, restored, established or re-established as expressed below and in conformance with the rules of the Michigan State Board of Registration for Land Surveyors or, by a Decree of a Court of law:

A- Description of original monument and accessories and/or subsequent restoration:

C. (continued)

6	7
Set 1"x36" pipe & ced. post w/loc. tag	Set 1"x36" pipe
7" Cedar N85°E 15.54	7" Cedar N37°W 80.18
5" Cedar S30°W 12.83	5" R. Pine S68°W 64.90
4" Cedar N19°W 9.00	Ced. post w/loc. tag
E-W fn. remains Due N 33'	Due W 44'
	Ctr. N-S b'top Co. road
	Due W 11'

B. Description of corner evidence found and/or method applied in restoring or re-establishing corner:


- I-2 Restored corner per previous survey by R.L.S. H. Bruning.
- J-3 Found old auto crank in place; raised to flush with blacktop with 1"x8" pipe. Corner previously used by R.L.S. H. Bruning.
- 5 Established N 1/16 corner on N-S 1/4 line by single proportion to U.S.; that is per prorated to G.L.O. plat (fractional sec.). Fd. old 1 1/4" pipe at fence corner (N-S-E) S51°E, 19.4 feet.
- 6 Set 1"x36" pipe at ctr. of frl. NE 1/4 of Sec. 2 on the basis of proration to G.L.O. plat (original U.S. survey - frl. section).
- 7 Set 1"x36" pipe prorated to original U.S. survey, G.L.O. plat (frl. section).

C. Description of monument for corner and accessories established to perpetuate locating the position of the corner:

I-2	J-3	5
Set 3/8"x3" spike in b.top	1"x8" pipe	Set 1"x36" pipe & ced. post
Power Pole N74°E 58.60	Corner fn. post Due N 29.20	w/loc. tag
1"x36" pipe S88°E 33.0	20" Maple S20°E 37.75	5" Cedar N30°W 32.9
Center US-31 Due W 2.6	on ctr. E-W b'top Co. rd.	9" Cedar N60°W 33.3
	in line w/old fn. N &	9" Y. Birch S77°E 13.6
	hedgerow S	N-S Random Due E 3'

SIGNED BY Carl F. Roser 8-20-75 DATE _____

SURVEYOR'S MICHIGAN REGISTRATION NO. 12028

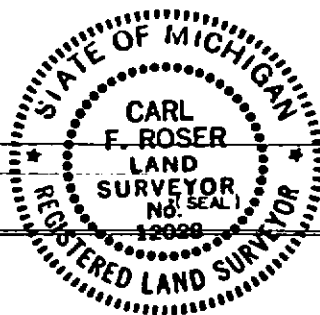

FOR STATE AND UNITED STATES AGENCIES:

SIGNED BY _____ DATE _____
CHIEF OF SURVEY PARTY

APPROVED AND SIGNED BY _____ DATE _____
MICHIGAN REGISTERED LAND SURVEYOR

(SEAL)

SURVEYOR'S MICHIGAN REGISTRATION NO. _____ SOUTH PART OF Benzie
 BENZONIA TOWNSHIP County