

APR 07 1998

LIBER 2 PAGE 133

SECTION

LAND CORNER RECORDATION CERTIFICATE
Filing Requirement of Act 74, Mich. P.A. 1970

For corners in

STATE OF MICHIGAN
 BENZIE COUNTY
 RECORDED

19 Jan 1998 9:37:33 AM
 MICHELLE R. GRAY
 REGISTER OF DEEDS
 # PAGES 002

<u>Benzie</u> (County)	Located In:	Corner Code #
1. Public Land Survey	T <u>25N</u> R <u>15W</u>	<u>E-10</u>
	T _____ R _____	_____
	T _____ R _____	_____
	T _____ R _____	_____
2. Property Controlling in Section	S _____ T _____ R _____	_____
	S _____ T _____ R _____	_____
3. Miscellaneous Property in Sec.	S _____ T _____ R _____	_____
	S _____ T _____ R _____	_____
4. Lot No. _____, Recorded Plat _____		
5. Private Claims _____		

Register of Deeds Stamp & File Number

	A	B	C	D	E	F	G	H	I	J	K	L	M
2	6	5	4	3	2	1							
3													
4	7	8	9	10	11	12							
5													
6	18	17	16	15	14	13							
7													
8	19	20	21	22	23	24							
9													
10	30	29	28	27	26	25							
11													
12	31	32	33	34	35	36							
13													

I, John B. Smendzuik, in a field survey on December 19, 19 97, do hereby certify that under requirements of P.A. 74, Michigan P.A. of 1970, the corner points mentioned in lines 1 and 2 above were in conformance with regulations and rules therefore as required in the current manual of survey instructions of the United States Department of the Interior, Bureau of Land Management or by a decree of a Court of Law and/or that the corner points mentioned in lines 3, 4 and 5 above were in conformance with the rules of the Michigan Board of Land Surveyors or by a Decree of a Court of Law; established, re-established, monumented, re-monumented, recovered, found as expressed below:

NOTE: Not more than 4 corners, all in the same town and range, may be recorded on this certificate.

A. Description of original monument and accessories and/or subsequent restoration:

E-10: 1838: GLO set post - Beech 12" S32°W 27 links and Beech 8" N31°E 16 links. GLO also has stream ties along the line. 1867: George Steele, Surveyor's Record No. 1, Page 88, shows distance from E-10 to E-9 (40.36 chains. 1871: George Steele does section work in section 28 and remeasures the line from E-10 to E-9 because he says it was measured over logs and brush and that this time he was more careful (40.31 chains). Steele also did work internally in Section 29 and has distances to Center of Section 29. 1993: Max Harris a Certificate of Survey, Job No. 93-3177, shows he found a 1/2" iron rod and witnessed it. 1996: John B. Smendzuik in Certificate of Survey, Job No. 96B5058, shows he found a 1/2" x 18" rebar 2.5' west of centerline of Swamp Road. Iron fits Harris witnesses and also fit well with GLO stream ties from original notes. Iron also fits reasonably with Steele measurements to Center of Section 29.

B. Description of corner evidence found and/or method applied in restoring or reestablishing corner:


E-10: 1997: Found 1/2" x 18" rebar on east-west occupation line and 2.5' West of centerline of road. The Benzie County Peer Group accepted the rebar as the best evidence of the location of the original corner.

Ratified by Peer Group
 In accordance with P.A. 345
 Chairman [Signature]
 Date 12/15/97

C. Description of monument for corner and accessories established to perpetuate locating the position of the corner:

E-10: Pulled rebar and set a 3" diameter Benzie County Remonumentation Program concrete monument with a brass cap in a monument box.

- 8" Ash N88°W 36.18' to found 60D spike.
- 20" Ash N35°W 57.22' to found double headed nail. (Harris witness)
- 6" Ash in clump of 3, S42°W 38.31' to found double headed nail. (Harris witness)
- 1/2 x 18" rebar with cap No. 30895 West 33.00'
- Centerline of Swamp Road is 2.5' East.

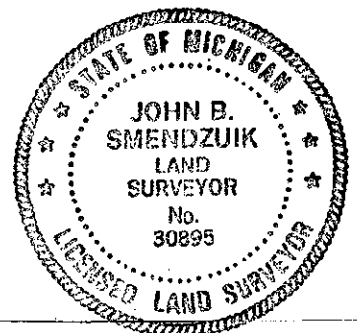

Signed by [Signature]
 Surveyor's Michigan License No. 30895

Date 1/18/98