

APR 07 1998

LIBER 2 PAGE 138

SECTION

LAND CORNER RECORDATION CERTIFICATE
Filing Requirement of Act 74, Mich. P.A. 1970

STATE OF MICHIGAN
BENZIE COUNTY
RECORDED

For corners in

Benzie
(County)

Located In:

Corner Code #

1. Public Land Survey

T 25N R 15W

K-5

T _____ R _____

T _____ R _____

T _____ R _____

2. Property Controlling in Section

S _____ T _____ R _____

S _____ T _____ R _____

3. Miscellaneous Property in Sec.

S _____ T _____ R _____

S _____ T _____ R _____

4. Lot No. _____, Recorded Plat _____

5. Private Claims _____

19 Jan 1998 9:38:39 AM
MICHELLE R. GRAY
REGISTER OF DEEDS
PAGES ONE

Register of Deeds Stamp & File Number

I, John B. Smendzuik, in a field survey on December 16, 19 97

do hereby certify that under requirements of P.A. 74, Michigan P.A. of 1970, the corner points mentioned in lines 1 and 2 above were in conformance with regulations and rules therefore as required in the current manual of survey instructions of the United States Department of the Interior, Bureau of Land Management or by a decree of a Court of Law and/or that the corner points mentioned in lines 3, 4 and 5 above were in conformance with the rules of the Michigan Board of Land Surveyors or by a Decree of a Court of Law; established, re-established, monumented, re-monumented, recovered, found as expressed below:

NOTE: Not more than 4 corners, all in the same town and range, may be recorded on this certificate.

	A	B	C	D	E	F	G	H	I	J	K	L	M
2	6	5	4	3	2	1							
3													
4	7	8	9	10	11	12							
5													
6	18	17	16	15	14	13							
7													
8	19	20	21	22	23	24							
9													
10	30	29	28	27	26	25							
11													
12	31	32	33	34	35	36							
13													

A. Description of original monument and accessories and/or subsequent restoration:

K-5: 1838: GLO set post - Hemlock 28" N72°E 52 links and Birch 14" S72°E 24 links. 1895: Frank S. Haswell, Surveyor's Record 1, Page 152, says he planted a hemlock post and filled hole with black dirt from the original bearing trees. 1935: Records of Unknown Surveyor, show 'T' rail and stone at corner. 1962: Harold R. Bruning, Old section corner records, Page 14, shows found small rail driven into remains of old Hemlock post. Bruning set a 1" x 3' galvanized iron pipe with aluminum cap, 8" below road surface and took new witnesses. 1970: Bruning reset 1" pipe x 4.5' long from witnesses. BCRP: Finds 1" pipe and sets cast iron marker. 1988: Bruce Jenema, Certificate of Survey in Liber 1 of surveys, page 963, shows found county marker, no witnesses. 1990: John Smendzuik, LCRC, Liber 1, Page 266, shows found county marker and witnesses.

B. Description of corner evidence found and/or method applied in restoring or reestablishing corner:


K-5: 1997: Found 19" of Benzie County cast iron Harrison marker flush with surface of paved road in intersection of Demerley and Wallaker Roads. Marker also fits well with Smendzuik and Bruning witnesses. The Benzie County Peer Group accepted the Benzie county marker as set by Bruning and perpetuated by the Road Commission as the perpetuation of the original GLO corner at K-5.

Ratified by Peer Group
In accordance with P.A. 345
Chairman J.B. Smendzuik
Date 12/15/97

C. Description of monument for corner and accessories established to perpetuate locating the position of the corner:

K-5: Removed the Benzie County cast iron Harrison marker and set a 3" diameter Benzie County Remonumentation Program concrete monument with a brass cap in a monument box.

- Power Pole N55°W 69.54' to found 60D spike. (Bruning witness).
- 10" Scotch Pine S84°E 39.60' to 60D spike. (Smendzuik witness)
- Corner fence post S47°E 46.68' to set BCRP tag and nail.
- 9" White Pine S52°W 111.41' to set BCRP tag and nail.

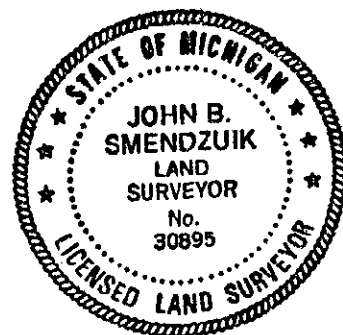

Signed by

J.B. Smendzuik

Date 1/18/98

Surveyor's Michigan License No.

30895