

**SURVEY & REMONUMENTATION**

APR 07 1998

LIBER 2 PAGE 140

**SECTION LAND CORNER RECORDATION CERTIFICATE**  
**Filing Requirement of Act 74, Mich. P.A. 1970**

STATE OF MICHIGAN  
 BENZIE COUNTY  
 RECORDED

19 Jan 1998 9:39:04 AM  
 MICHELLE R. GRAY  
 REGISTER OF DEEDS  
 # PAGES One

Register of Deeds Stamp & File Number

For corners in Benzie (County) Located In: Corner Code ##

1. Public Land Survey T 25N R 15W K-7  
 T \_\_\_\_\_ R \_\_\_\_\_  
 T \_\_\_\_\_ R \_\_\_\_\_  
 T \_\_\_\_\_ R \_\_\_\_\_

2. Property Controlling S \_\_\_\_\_ T \_\_\_\_\_ R \_\_\_\_\_  
 in Section S \_\_\_\_\_ T \_\_\_\_\_ R \_\_\_\_\_

3. Miscellaneous S \_\_\_\_\_ T \_\_\_\_\_ R \_\_\_\_\_  
 Property in Sec. S \_\_\_\_\_ T \_\_\_\_\_ R \_\_\_\_\_

4. Lot No. \_\_\_\_\_, Recorded Plat \_\_\_\_\_

5. Private Claims \_\_\_\_\_

	A	B	C	D	E	F	G	H	I	J	K	L	M
2	6		5		4		3		2		1		
3													
4	7		8		9		10		11		12		
5													
6	18		17		16		15		14		13		
7													
8	19		20		21		22		23		24		
9													
10	30		29		28		27		26		25		
11													
12	31		32		33		34		35		36		
13													

John B. Smendzuik, in a field survey on December 16, 19 97  
 do hereby certify that under requirements of P.A. 74, Michigan P.A. of 1970, the corner points mentioned  
 in lines 1 and 2 above were in conformance with regulations and rules therefore as required in the  
 current manual of survey instructions of the United States Department of the Interior, Bureau of Land  
 Management or by a decree of a Court of Law and/or that the corner points mentioned in lines 3, 4 and 5  
 above were in conformance with the rules of the Michigan Board of Land Surveyors or by a Decree of a  
 Court of Law; established, re-established, monumented, re-monumented, recovered, found as  
 expressed below:

**NOTE: Not more than 4 corners, all in the same town and range, may be recorded on this certificate.**

**A. Description of original monument and accessories and/or subsequent restoration:**

K-7: 1838: GLO set post - Sugar 16" S58°W 29 links and Elm 22" N33°E 16 links. 1895: Frank S. Haswell, Surveyor's Record 1, Page 152, says he planted a green stone and crockery planted. 1935: Records of Unknown Surveyor, show Iron, stone and crockery with 2 Elm witnesses and on line of fence to East. 1970: Harold R. Bruning found 1/2" iron pipe at corner. Undated BCRC records show they found a 3/4" pipe surrounded by rocks and a piece of iron that looked like a horseshoe and took witnesses. 1988: Bruce Jenema, Certificate of Survey in Liber 1 of surveys, page 963, shows found county marker, no witnesses. 1990: John Smendzuik, LCRC, Liber 1, Page 266, shows found county marker and witnesses. Area of corner is in a large fill as BCRC reconstructed Wallaker Road around 1974.

**B. Description of corner evidence found and/or method applied in restoring or reestablishing corner:**


K-7: 1997: Found 8" of 3/4" galvanized iron pipe over, 3" below grade, 22" of 3/4" iron pipe with pinched bottom with stones around it and a horseshoe around that all 18" below grade. Also found pieces of clay tile and ceramic dishes under the stones, all being over the remains of a wood stake, 32" below road grade. Also found all kinds of scrap metal thrown in the hole, buckle, plow point etc.. The Benzie County Peer Group accepted the iron as found by the Road Commission as the best available evidence of the location of the original GLO corner at K-5. This corner is in the intersection of Mick and Wallaker Roads.

Ratified by Peer Group  
 In accordance with P.A. 345  
 Chairman [Signature]  
 Date 12/15/97

**Description of monument for corner and accessories established to perpetuate locating the position of the corner:**

K-7: Removed all of the above and set a 3" diameter Benzie County Remonumentation Program concrete monument with a brass cap in a monument box.

- 30" Maple S85°E 33.45' to found 60D spike.
- 8" W. Pine S59°E 49.58' to found 60D spike in a blazed tree.
- 7" Ash S33°E 54.33' to found 60D spike in a blazed tree.
- Power Pole N24°W 148.91' to set BCRP tag and nail.
- Bruce Jenema iron and cap East 31.62'

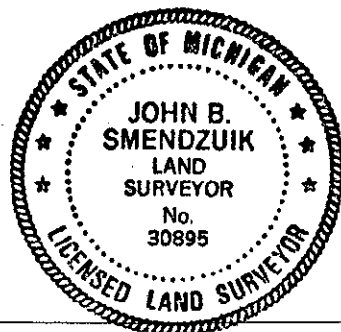

igned by [Signature] Date 1/18/98  
 Surveyor's Michigan License No. 30895