

SECTION

LAND CORNER RECORDATION CERTIFICATE

Filing Requirement of Act 74, Mich. PA 1970

For Corners In:
BENZIE
 (County)

	Located In	Corner Code #
1. Public Land Survey	T <u>25N</u> R <u>15W</u>	<u>K-12</u>
	T _____ R _____	_____
2. Property Controlling in Section	S _____ T _____ R _____	_____
	S _____ T _____ R _____	_____
3. Miscellaneous Property in Section	S _____ T _____ R _____	_____
	S _____ T _____ R _____	_____
4. Lot No: _____	Recorded Plat: _____	
5. Private Claims: _____		

STATE OF MICHIGAN
BENZIE COUNTY
RECORDED

1 FEB 2000 1:56:44 PM
MICHELLE R. GRAY
REGISTER OF DEEDS
PAGES ONE

Register of Deeds Stamp & File Number

I, John B. Smendzduk in a field survey on September 16, 1999 do hereby state that under requirements of PA 74, Michigan PA of 1970, the corner points mentioned in lines 1 and 2 above were in conformance with regulations and rules therefore as required in the current manual of survey instructions of the United States Department of the Interior, Bureau of Land Management or by a decree of a Court of Law and/or that the corner points mentioned in lines 3, 4 and 5 above were in conformance with the rules of the Michigan Board of Land Surveyors or by a Decree of a Court of Law; established, re-established, monumented, recovered, found as expressed below:

NOTE: Not more than 2 corners, all in the same town and range, may be recorded on this certificate.

A	B	C	D	E	F	G	H	I	J	K	L	M
1												
2	6	5	4	3	2	1						
3												
4	7	8	9	10	11	12						
5												
6	18	17	16	15	14	13						
7												
8	19	20	21	22	23	24						
9												
10	30	29	28	27	26	25						
11												
12	31	32	33	34	35	36						
13												

A. Description of original monument and accessories and/or subsequent restoration:

1838: GLO set post and witnesses - 10" Beech N87°E 10 links and 14" Beech N83°W 42 links. 1991: Max Harris, in a LCRC filed in Liber 1, Page 276, says he reset corner on line between corners K-11 and K-13 and on an east-west fence line. 1999: Bob Mitchell in an unrecorded Certificate of Survey, used and agreed with the corner set by Max Harris.

B. Description of corner evidence found and/or method applies in restoring or re-establishing corner:

1999: Found Max Harris 1/2 x 24" iron rebar. The Benzie County Peer Group accepted the iron bar as the perpetuation of the original GLO corner from the best available evidence.

Ratified by Peer Group
In accordance with P.A. 345

Chairman [Signature]


Date 9/14/99

C. Description of monument for corner and accessories established to perpetuate locating the position of the corner:

Removed the 1/2" iron rebar and set a standard 3" diameter Benzie County Remonumentation Program concrete monument with a brass cap in a monument box.

- 10" Cherry N63°E 60.22' to a set spike.
- 6" Maple N87°E 57.56' to a found nail and washer.
- Power Pole S16°W 145.67' to set nail and BCRP tag.
- 1/2" x 18" rebar with cap 30895 S34°E 51.14'
- 1/2" x 18" rebar with cap 30895 N43°W 44.92'

Corner is in centerline of Wallaker Road.

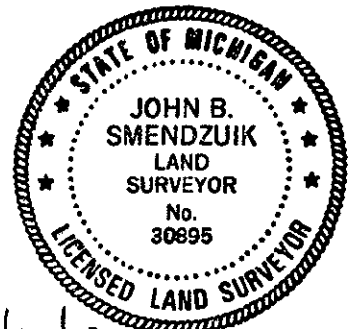

Signed by: [Signature]
Surveyor's Michigan License No.: 30895

Date: 1/31/2000