

MAR 09 2000

SECTION

LAND CORNER RECORDATION CERTIFICATE

LIBER 2 PAGE 313

Filing Requirement of Act 74, Mich. PA 1970

For Corners In: BENZIE (County)

Located In Corner Code #

Table with 4 columns: Survey Type, Located In (T, R, S), and Corner Code #. Includes entries for Public Land Survey, Property Controlling in Section, and Miscellaneous Property in Section.

STATE OF MICHIGAN BENZIE COUNTY RECORDED

1 FEB 2000 1:56:32 PM MICHELLE R. GRAY REGISTER OF DEEDS # PAGES ONE

Register of Deeds Stamp & File Number

4. Lot No: Recorded Plat: 5. Private Claims:

I, John B. SmendzuiK in a field survey on September 15, 1999 do hereby state that under requirements of PA 74, Michigan PA of 1970, the corner points mentioned in lines 1 and 2 above were in conformance with regulations and rules therefore as required in the current manual of survey instructions of the United States Department of the Interior, Bureau of Land Management or by a decree of a Court of Law and/or that the corner points mentioned in lines 3, 4 and 5 above were in conformance with the rules of the Michigan Board of Land Surveyors or by a Decree of a Court of Law; established, re-established, monumented, recovered, found as expressed below:

NOTE: Not more than 2 corners, all in the same town and range, may be recorded on this certificate.

Grid table with columns A-M and rows 1-13. Contains numbers 1-36 in a grid pattern.

A. Description of original monument and accessories and/or subsequent restoration:

1838: GLO set post and witnesses - 8" Beech N18°W 26 links and 10" Beech N58°E 50 links. 1927: J. H. Millard, found iron point at '+' road. New witnesses - 20" Sugar S62 1/2°E 50 links and 24" Sugar S45 1/2°W 55 links. 1935: Notes of FAF, shows 1 1/2" iron pipe and 3 witnesses. 1964: BCRC found a 1 1/2" iron pipe and witnessed it. 1964: BCRC set 1/2" iron pipe after construction work on road. 1991: Max Harris, LCRC in Liber 1, Page 276, found 1/2" iron pipe per BCRC records.

B. Description of corner evidence found and/or method applies in restoring or re-establishing corner:

1999: Found a 1/2" x 15" iron pipe at existing grade which fits with BCRC witnesses. The Benzie County Peer Group accepted found iron pipe as the best evidence of the perpetuation of the GLO corner.


Ratified by Peer Group In accordance with P.A. 345 Chairman [Signature] Date 9/14/99

C. Description of monument for corner and accessories established to perpetuate locating the position of the corner:

Set a standard 3" diameter Benzie County Remonumentation Program concrete monument with a brass cap in a monument box.

- 8" Corner fence post S34°E 42.98' to a found nail in top of post. 42" Maple S46°W 36.86' to a set double headed nail and BCRP tag. 12" W. Pine N45°E 74.16' to a found double headed nail and washer. Stop sign post N26°W 50.32'.

Corner is in the intersection of North Manistee County Line Road and Wallaker Road.

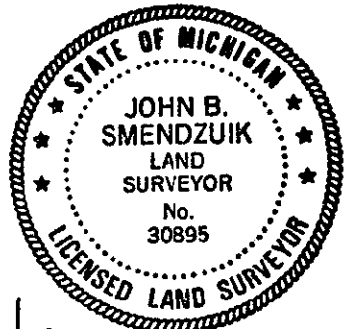

Signed by: [Signature] Surveyor's Michigan License No.: 30895

Date: 1/31/2000