

STATE OF MICHIGAN  
DEPARTMENT  
OF  
NATURAL RESOURCES

LAND CORNER RECORD


BENZIE COUNTY  
T 26 N R 13 W

DESCRIPTION OF CORNER W 1/4 corner, Sec. 6

CORNER MONUMENT Found 1" pipe. Added DNR Monument

DATE MONUMENT PLACED AND WITNESSED 4-25-72

WITNESSES TO CORNER..... 14" Twin Maple N 79 E 19.1'

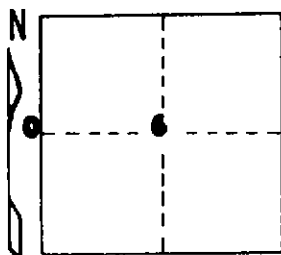

7" Ironwood S 33W 32.6'


10" Maple N 45 W 15.6'

AND

CIRCLE CORNER REGISTERED

DESCRIPTION IN DETAIL AS TO HOW CORNER WAS LOCATED AND IDENTIFIED OR RESTORED.

**Found 1" pipe by remains of fence corner, fence remains N-S-E.**

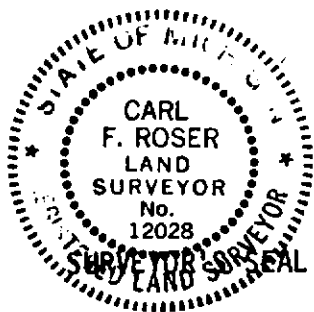

SIGNED

*Carl F. Roser*

DATE

5-23-72

REGISTERED LAND SURVEYOR **12028**

DISTRIBUTION:

County Courthouse  
Area Forester (Regions I & II)  
District or Region Surveyor  
Forestry Div., Lansing

R 4047  
Rev. 10/68