

STATE OF MICHIGAN
DEPARTMENT
OF
NATURAL RESOURCES

LAND CORNER RECORD

BENZIE COUNTY


T 26 N R 13 W

DESCRIPTION OF CORNER SE Corner Sec. 7

CORNER MONUMENT Found 3/4" Pipe - Added D.N.R. Monument

DATE MONUMENT PLACED AND WITNESSED 4-24-72

WITNESSES TO CORNER..... 14" B. Cherry E 44 W 50.7'

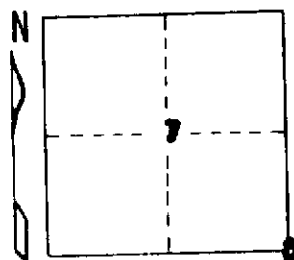

4" Ironwood N 51 W 36.3'


9" Ironwood S 48 E 66.5'

AND
Set Cedar Post w/loc. tag DUB W 33'

CIRCLE CORNER REGISTERED

DESCRIPTION IN DETAIL AS TO HOW CORNER WAS LOCATED AND IDENTIFIED OR RESTORED.

Recovered 3/4" pipe from previous Department survey dating back to Caid survey in 1939.

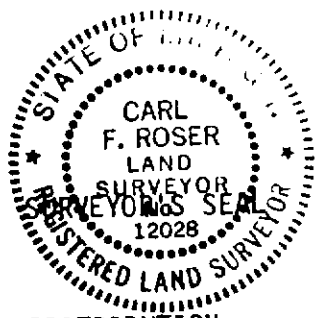

DISTRIBUTION:

SIGNED

Carl F. Roser
REGISTERED LAND SURVEYOR **12028**

DATE

5-23-72

County Courthouse
Area Forester (Regions I & II)
District or Region Surveyor
Forestry Div., Lansing

R 4047
Rev. 10/68