

STATE OF MICHIGAN
DEPARTMENT
OF
NATURAL RESOURCES

LAND CORNER RECORD


BENZIE COUNTY
T 26 N R 13 W

DESCRIPTION OF CORNER E 1/4 Sec. 7

CORNER MONUMENT Set DNR Monument

DATE MONUMENT PLACED AND WITNESSED 4-24-72

WITNESSES TO CORNER..... 12" Ironwood S 57 W 50.9'

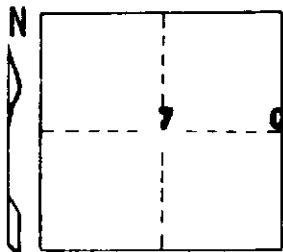

10" Maple N 70 E 40.1'


10" Maple S 59 E 31.3'

AND
Set Cedar Post w/Loc. Tag DUE W 33'

CIRCLE CORNER REGISTERED

DESCRIPTION IN DETAIL AS TO HOW CORNER WAS LOCATED AND IDENTIFIED OR RESTORED.

Corner reestablished equidistant and on line between recovered Sec. corners to N & S. Corner fence post (irregular fence N & E) approximately 44' E & 5' S. Corner falls in approximate center of dirt road N.

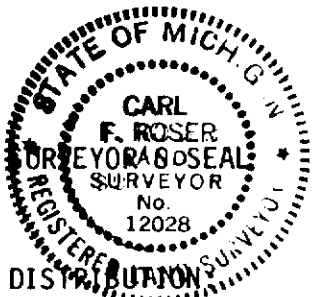

SIGNED

Carl F. Roser
REGISTERED LAND SURVEYOR

DATE

5-23-72

12028

County Courthouse
Area Forester (Regions I & II)
District or Region Surveyor
Forestry Div., Lansing