

STATE OF MICHIGAN  
DEPARTMENT  
OF  
NATURAL RESOURCES  
LAND CORNER RECORD


DEWIE COUNTY  
T 26 N R 13 W

DESCRIPTION OF CORNER Center of NE 1/4, Section 7

CORNER MONUMENT Set 1"x36" Pipe & Cedar Post w/loc tag

DATE MONUMENT PLACED AND WITNESSED 4-25-72

WITNESSES TO CORNER..... 2" E. Pine N 82 W 87.5'

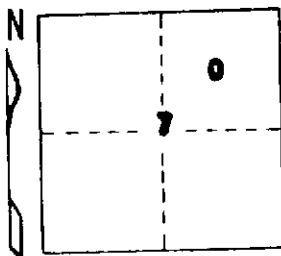

3" E. Pine S 59 W 71.5'


N-S Fence DUE E 2'

AND

CIRCLE CORNER REGISTERED

DESCRIPTION IN DETAIL AS TO HOW CORNER WAS LOCATED AND IDENTIFIED OR RESTORED.

**Corner established per Standard B.L.N. regulations.**

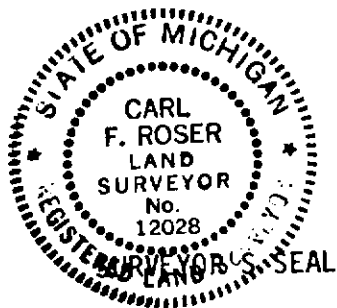

SIGNED Carl F. Roser DATE 5-23-72  
REGISTERED LAND SURVEYOR **12028**

DISTRIBUTION:

County Courthouse  
Area Forester (Regions I & II)  
District or Region Surveyor  
Forestry Div., Lansing

R 4047  
Rev. 10/68