

LAND CORNER RECORDATION CERTIFICATE

FILING REQUIREMENT OF ACT 74, MICH. P.A.1970

| FOR CORNERS OF-- | LOCATED IN-- | CORNER CODE NUMBER |
|-------------------------------------------|----------------------|--------------------|
| 1. PUBLIC LAND SURVEY..... | T. 26 N. R. 13 W. | I-12; H-13; I-13 |
| 2. PROPERTY CONTROLLING IN SECTION..... | 36 T. 26 N. R. 13 W. | 14 |
| 3. MISCELLANEOUS PROPERTY IN SECTION..... | T. N. R. E. S. W. | |
| 4. LOT NO., RECORDED PLAT..... | | |
| 5. PRIVATE CLAIMS | | |

REGISTER OF DEEDS STAMP AND
FILING NUMBER

I, Carl F. Roser, do hereby certify that under requirements of P.A. 74, Michigan P.A. of 1970, the corner points mentioned in lines 1 and 2 above were, in a field survey on November 18, 1980, established, re-established, monumented, re-monumented, recovered or restored as expressed below and in conformance with regulations and rules therefore as required in the current manual of survey instructions of the United States Department of the Interior, Bureau of Land Management or by a decree of a court of law. Furthermore, that the corner points mentioned in lines 3, 4 and 5 above were, in a field survey on _____, 19____, found, recovered, restored, established or re-established as expressed below and in conformance with the rules of the Michigan State Board of Registration for Land Surveyors or, by a Decree of a Court of law:

A. Description of original monument and accessories and or subsequent restoration:

- B. Description of corner evidence found and/or method applied in restoring or re-establishing corner:
- I-12 Re-Established E $\frac{1}{4}$ Cor of S-34; equidistant & on line between NE & SE corners of Sec. 34
 - H-13 Re-established S $\frac{1}{4}$ cor. of Sec. 34 mid-way & on line between SW & SE corners of Sec 34. The N $\frac{1}{4}$ Cor. of Sec 3, T25N-R13W, is S89 $^{\circ}$ 28'E 119.58'.
 - I-13 Re-established corner common to Sec's 34 & 35 on south line of T26N-R13W by single proportion to G.L.O. survey (& on twp. line) between found S $\frac{1}{4}$ cor. of S-32 & found SE cor. of S-36. The corner common to Sec's 2 & 3 on N line of T25N-R13W is S89 $^{\circ}$ 28'E 107.75'.
 - 14 Fd. $\frac{1}{2}$ rod by R.L.S., Bill Batzer.

- C. Description of monument for corner and accessories established to perpetuate locating the position of the corner:
- | | | |
|---|---|---|
| <p>I-12 Set D.N.R. mon. in 1$\frac{1}{2}$x5' pipe 2' above grd. & added ced.post 8" Ced. S50$^{\circ}$W 69.5 4" Tamrack N25$^{\circ}$E 47.5 10" Ced S22$^{\circ}$W 103.0'</p> | <p>H-13 Set D.N.R. mon & ced Post 5" Maple N05$^{\circ}$E 32.4' 2" Pin Cherry N50$^{\circ}$E 28.9' 3" Maple S80$^{\circ}$W 20.0' 14 Fd $\frac{1}{2}$ rd w/R.L.S. cap #I3026 19" Oak S31$^{\circ}$E 51.7' 7" Maple S58$^{\circ}$W 75.5' 8" Oak N40$^{\circ}$W 89.6 Set cedar post w/loc tag, EI8', Ctr N-S blk t. rd, W, I5'</p> | <p>I-13 Set D.N.R. Mon & Cedar Post 12" Maple (triple) S15$^{\circ}$E 52.4 16" Maple (triple) S16$^{\circ}$W 60.6 8" Maple (twin) S75$^{\circ}$W 84.0</p> |
|---|---|---|

SIGNED BY Carl F. Roser 02/20/81 DATE _____


SURVEYOR'S MICHIGAN REGISTRATION NO. 12028

FOR STATE AND UNITED STATES AGENCIES:

SIGNED BY _____ DATE _____
CHIEF OF SURVEY PARTY

APPROVED AND SIGNED BY _____ DATE _____
MICHIGAN REGISTERED LAND SURVEYOR

SURVEYOR'S MICHIGAN REGISTRATION NO. _____

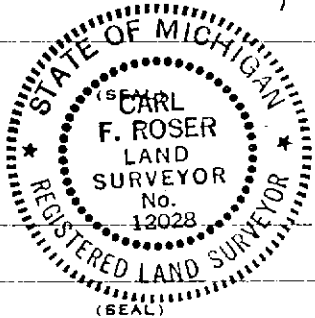

*Inland Twp.
Benzie County*