

LAND CORNER RECORDATION CERTIFICATE

FILING REQUIREMENT OF ACT 74, MICH. P.A.1970

FOR CORNERS OF --:	LOCATED IN --:	CORNER CODE NUMBER
1. PUBLIC LAND SURVEY	T. 26 N. R. 13 W.	E-10
2. PROPERTY CONTROLLING IN SECTION 29	T. 26 N. R. 13 W.	15
3. MISCELLANEOUS PROPERTY IN SECTION	T. S. R. E. W.	
4. LOT NO. _____, RECORDED PLAT _____		
5. PRIVATE CLAIMS _____		

REGISTER OF DEEDS STAMP AND
FILING NUMBER

I, Carl F. Roser, do hereby certify that under requirements of P.A. 74, Michigan P.A. of 1970, the corner points mentioned in lines 1 and 2 above were, in a field survey on July 29, 1980, established, re-established, monumented, re-monumented, recovered or restored as expressed below and in conformance with regulations and rules therefore as required in the current manual of survey instructions of the United States Department of the Interior, Bureau of Land Management or by a decree of a court of law. Furthermore, that the corner points mentioned in lines 3, 4 and 5 above were, in a field survey on _____, 19____, found, recovered, restored, established or re-established as expressed below and in conformance with the rules of the Michigan State Board of Registration for Land Surveyors or, by a Decree of a Court of law:

XX

B. Cont.

- 15 Recovered old subdivision monument (1" pipe set in conc.) for W. 1/8 Cor. on S. line of Sec. 29: per 1927 plat of "Turtle Lake Resort".

B. Description of corner evidence found and/or method applied in restoring or re-establishing corner:

- E-10 Recovered 1" solid iron rod with 1 1/4" half-pipe (cut length wise) along side. Accepted 1" solid iron for E 1/4 cor. of Sec. 29 as it fits line across fd. W 1/4 Sec. 29 & a point 33.00'-N. of fd. old Conc. Mon. at NE Corner of Block 61, 1927 plat of "Turtle Lake Resort" near ctr. of Sec. 29. The History of the 1" Solid Iron is that it is the Cinder Road (Bit Surfaced Co. Rd.) P.I. as set by Co. Rd. Survey at position of Fd. old wooden stake in line with narrow two track road West & NE; per conversation with Harold Saffron who worked with Mead on Survey to upgrade Cinder Road many years ago.

C. Description of monument for corner and accessories established to perpetuate locating the position of the corner:

E-10	15
Fd 1" Ir. Rod & added Ced. Post w/loc Tag	(Added Cedar Post w/loc tag)
4" Oak S10°E 22.6	Fd 1" pipe in Conc. (flush w/ground)
7" Maple S38°W 79.6	8" Maple N38°E 42.7
4" W. Pine S70°W 68.2	16" Maple S51°E 29.1
Fd. 1 1/4" half-pipe West 5.45	9" Cherry S45°W 19.8
Ctr Blk T. Rd. North 76'±	Ctr. N-S dirt trail rd. E. 190'±
Cor is in line w/ctr Blk T. Rd. W&NE	

SIGNED BY Carl F. Roser 2/20/81

DATE

SURVEYOR'S MICHIGAN REGISTRATION NO. 12028


FOR STATE AND UNITED STATES AGENCIES:

SIGNED BY _____
CHIEF OF SURVEY PARTY

DATE

APPROVED AND SIGNED BY _____
MICHIGAN REGISTERED LAND SURVEYOR

DATE

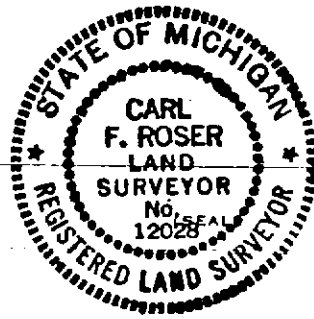

(SEAL)

Inland Township
BENZIE COUNTY

SURVEYOR'S MICHIGAN REGISTRATION NO. _____