

LAND CORNER RECORDATION CERTIFICATE

FILING REQUIREMENT OF ACT 74, MICH. P.A.1970

FOR CORNERS OF--:	LOCATED IN--:	CORNER CODE NUMBER
1. PUBLIC LAND SURVEY	T. 26 N. R. 13 W.	C-11; D-10
2. PROPERTY CONTROLLING IN SECTION	T. S. R. E. W.	
3. MISCELLANEOUS PROPERTY IN SECTION	T. S. R. E. W.	
4. LOT NO. , RECORDED PLAT		
5. PRIVATE CLAIMS		

REGISTER OF DEEDS STAMP AND FILING NUMBER

I, Carl F. Roser, do hereby certify that under requirements of P.A. 74, Michigan P.A. of 1970, the corner points mentioned in lines 1 and 2 above were, in a field survey on July 28, 1980, established, re-established, monumented, re-monumented, recovered or restored as expressed below and in conformance with regulations and rules therefore as required in the current manual of survey instructions of the United States Department of the Interior, Bureau of Land Management or by a decree of a court of law. Furthermore, that the corner points mentioned in lines 3, 4 and 5 above were, in a field survey on _____, 19____, found, recovered, restored, established or re-established as expressed below and in conformance with the rules of the Michigan State Board of Registration for Land Surveyors or, by a Decree of a Court of law:

A. Description of original monument and accessories and/or subsequent restoration:

- B. Description of corner evidence found and/or method applied in restoring or re-establishing corner:
- C-11 Recovered old 1 1/4" pipe that fits subdivision of part of SW 1/4 of Sec. 29 per 1927 plat of "Turtle Lake Resort".
 - D-10 Established ctr. Sec. 29 at Intersection of E-W 1/4 line & line between fd N 1/4 S-29 and Fd old plat Mon. S00°00' 54"E 667.17'. Fd old plat Row Mon. S44°38'W 46.95'. Ct. E-W B. Top road is North, 4.1'. This is the ctr. of Sec. 29 per 1927 plat of "Turtle Lake Resort". The ctr. of Sec. 29 (Fd. R.R. spk) per 1954 plat of "Sportsman's Paradise" is N87°02'E, 52.69'.

C. Description of monument for corner and accessories established to perpetuate locating the position of the corner:

C-11	D-10
Fd 1 1/4" pipe; replaced w/DNR Mon. & added Ced. Post w/loc. tag.	Drove 1"x18" Rod in Bit. Surface Road
6" Maple N01°W 22.7	8" R. Pine N46°E 69.00
12" Maple S75°W 23.9	7" R. Pine S41°W 53.29
11" Maple S50°E 51.3	10" Cherry S37°E 55.02
	Fd R.R. spk N87°02'E 52.69'
	Fd. 3/4" pipe burried 1'± N10°43'W 12.36'


SIGNED BY Carl F. Roser 2/20/81 DATE _____

SURVEYOR'S MICHIGAN REGISTRATION NO. 12028

FOR STATE AND UNITED STATES AGENCIES:

SIGNED BY _____ DATE _____

APPROVED AND SIGNED BY _____ DATE _____

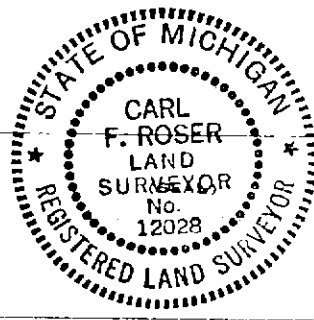

(SEAL)
Inland Township
BENZIE COUNTY

SURVEYOR'S MICHIGAN REGISTRATION NO. _____