

LAND CORNER RECORDATION CERTIFICATE

FILING REQUIREMENT OF ACT 74, MICH. P.A.1970

FOR CORNERS OF--:	LOCATED IN--:	CORNER CODE NUMBER
1. PUBLIC LAND SURVEY _____ T. _____ N. S., R. _____ E. W.		
2. PROPERTY CONTROLLING IN SECTION <u>8</u> T. <u>26N</u> N. S., R. <u>13W</u> E. W.		←←← 11, 12, 13
3. MISCELLANEOUS PROPERTY IN SECTION _____ T. _____ N. S., R. _____ E. W.		
4. LOT NO. _____, RECORDED PLAT _____		
5. PRIVATE CLAIMS _____		

REGISTER OF DEEDS STAMP AND
FILING NUMBER

I, CARL F. ROSER, do hereby certify that under requirements of P.A. 74, Michigan P.A. of 1970, the corner points mentioned in lines 1 and 2 above were, in a field survey on 6/15, 1982, established, re-established, monumented, re-monumented, recovered or restored as expressed below and in conformance with regulations and rules therefore as required in the current manual of survey instructions of the United States Department of the Interior, Bureau of Land Management or by a decree of a court of law. Furthermore, that the corner points mentioned in lines 3, 4 and 5 above were, in a field survey on _____, 19____, found, recovered, restored, established or re-established as expressed below and in conformance with the rules of the Michigan State Board of Registration for Land Surveyors or, by a Decree of a Court of law:

A. Description of original monument and accessories and/or subsequent restoration:

- B. Description of corner evidence found and/or method applied in restoring or re-establishing corner:
- 11. ESTAB. CTR OF SW 1/4 OF SEC 8 PER STD B.L.M. INSTRUCTIONS
 - 12. ESTAB. SE COR OF NE 1/4-SW 1/4 OF SEC 8 MID-WAY & ON LINE BETW RECOVERED CTR & S 1/4 COR'S OF SEC. 8.
 - 13. ESTAB CTR OF SE 1/4 OF SEC 8 PER STD B.L.M. INSTRUCTIONS

C. Description of monument for corner and accessories established to perpetuate locating the position of the corner:

<p style="text-align: center;">11</p> <p>DROVE 5/8"X36" ROD W/RLS CAP & SET CED POST W/LOC TAG.</p> <p>10" CHERRY N10°E 34.8</p> <p>6" MAPLE N80°W 21.8</p> <p>5" MAPLE S10°W 20.5</p>	<p style="text-align: center;">12</p> <p>DROVE 5/8"X36" RE-ROD W/RLS CAP; & SET CED POST W/LOC TAG.</p> <p>5" TW MAP N56°E 8.4</p> <p>6" MAPLE N74°W 18.5</p> <p>4" MAPLE S02°W 50.5</p>	<p style="text-align: center;">13</p> <p>DROVE 5/8"X36" REROD & SET CED POST W/LOC TAG.</p> <p>12" MAPLE N66°W 15.6'</p> <p>11" TW MAP N45°E 10.6'</p> <p>8" MAPLE S30°W 29.1'</p> <p>SW COR OF PINE PLANT, ^{East} 20'±</p>
--	--	--


SIGNED BY Carl F. Roser DATE 6-28-82

SURVEYOR'S MICHIGAN REGISTRATION NO. _____

FOR STATE AND UNITED STATES AGENCIES:

SIGNED BY _____ DATE _____
CHIEF OF SURVEY PARTY

APPROVED AND SIGNED BY _____ DATE _____
MICHIGAN REGISTERED LAND SURVEYOR

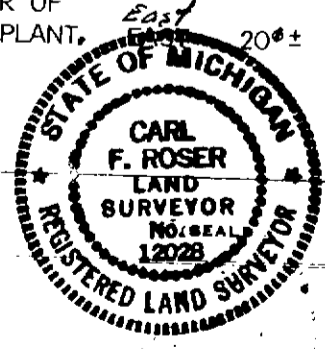

SURVEYOR'S MICHIGAN REGISTRATION NO. _____

*Inland Twp.
Benzie Co.*