LAND CORNER RECORDATION CERTIFICATE

Filing Requirement of Act 74, Mich. P.A. 1970

For corners in BENZIE (County)

	Located in:	Corner Code ##
1. Public Land Survey	T 26N R 13W	A-7
	T ___ R ___	A-8
	T ___ R ___	B-7
	T ___ R ___	
2. Property Controlling	S 19 T ___ R ___	2
in Section	S ___ T ___ R ___	
3. Miscellaneous	S ___ T ___ R ___	
Property in Sec.	S ___ T ___ R ___	

8/7/89

Register of Deeds Stamp & File Number

4. Lot No. _____ , Recorded Plat _____

5. Private Claims _____

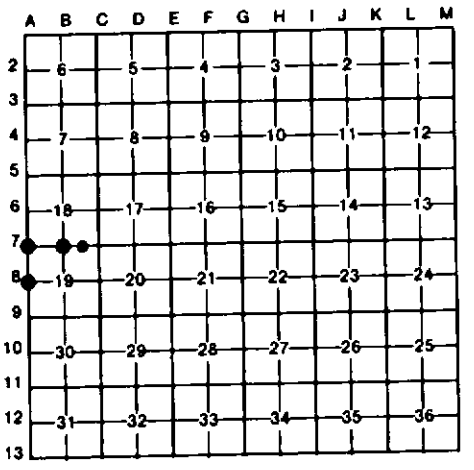

I, CARL F. ROSER, in a field survey on JULY 7, 19 87, do hereby certify that under requirements of P.A. 74, Michigan P.A. of 1970, the corner points mentioned in lines 1 and 2 above were in conformance with regulations and rules therefore as required in the current manual of survey instructions of the United States Department of the Interior, Bureau of Land Management or by a decree of a Court of Law and/or that the corner points mentioned in lines 3, 4 and 5 above were in conformance with the rules of the Michigan Board of Land Surveyors or by a Decree of a Court of Law; established, re-established, monumented, re-monumented, recovered, found as expressed below:

NOTE: Not more than 4 corners, all in the same town and range, may be recorded on this certificate.

A. Description of original monument and accessories and/or subsequent restoration:

A-7

A-8

B-7

2

B. Description of corner evidence found and/or method applied in restoring or reestablishing corner:

A-7

FD BRASS CAPPED CONC. MON IN B.TOP RD FOR NW COR S-19. K. OSTLING ALSO USED THIS BRASS CAPPED CONC. MON IN 1968 DEPT. SUR OF S-18. SHADKO FD IR PIN IN 1944 & REPLACED W/BRASS CAPPED CONC. MON (P.F.S. MON).

A-8

FD 1 1/4" PIPE (8" DEEP) FOR N 1/4 COR S-19. COR IS IN CTR OF N-S COUNTY B.TOP ROAD.

B-7

FD IR FOR N 1/4 COR THAT FITS K. OSTLING 1968 SURVEY OF S-18. K. OSTLING BELIEVED IR TO BE FROM C.N.CAID 1939 SURVEY.

2

ESTABLISHED NE COR OF NW 1/4-NE 1/4 OF S-19 PER STANDARD B.L.M. INSTRUCTIONS. COR FALLS AT N. EDGE OF E-W TWO TRACK TRAIL; COR BURIED 0.3'.

C. Description of monument for corner and accessories established to perpetuate locating the position of the corner:

A-7

FD BRASS CAPPED CONC. MON IN B.TOP RD. INTERSEC N-S-W & SR RD E.

29" WALNUT	S29°E	43.09
24" MAPLE	N68°E	69.53
16" MAPLE	N19°W	54.62
STOP SIGN POST	S69°W	44.8'

A-8

FD 1 1/4" PIPE (RAISED W/1 1/4" X 7" PIPE)

*P.POLE	S42°E	53.98
*T.POLE	N73°E	30.40
CTR TELE RISER BOX	N27°W	50.50
12" R PINE	S75°W	37.65

*FD WITS.

B-7

FD 3/4" IR ROD (BURIED 0.4').

5" MAPLE CLP 3	N28°E	27.2'
6" R PINE	N55°E	35.2'
*8" MAPLE	S52°E	39.4'
10" MAPL CLP 2	S27°E	5.6'
CTR E-W 2-TRK	NORTH	3'±
SET CED POST W/LOC TAG.	SOUTH	16.5'

*KEN OSTLING 1968 WIT.

2

DROVE 5/8" X 34" REROD W/RLS CAP.

9" MAPL CLP 3	N25°W	63.7'
15" MAPL	N68°E	126.8'
CTR E-W 2-TRK	SOUTH	4'±
SET CED POST W/LOC TAG	SOUTH	16.5'

Signed by Carl F. Roser 8-29-88 Date _____

Surveyor's Michigan License No. 12028

FORM APPROVED BY MICHIGAN STATE BOARD OF LAND SURVEYORS, JAN. 28, 1971 REVISED MAY 14, 1975 REVISED JAN. 1983

STATE OF MICHIGAN CARL F. ROSER LAND SURVEYOR No. 12028 REGISTERED LAND SURVEYOR