LAND CORNER RECORDATION CERTIFICATE

Filing Requirement of Act 74, Mich. P.A. 1970

For corners in
BENZIE
(County)

	Located In:	Corner Code ##
1. Public Land Survey	T 26N R 13W	A-9
	T ___ R ___	B-9
	T ___ R ___	B-10
	T ___ R ___	
2. Property Controlling	S 30 T ___ R ___	2
in Section	S ___ T ___ R ___	
3. Miscellaneous	S ___ T ___ R ___	
Property in Sec.	S ___ T ___ R ___	

Filed 8/7/89 [illegible] Register of Deeds Stamp & File Number

4. Lot No. _____ , Recorded Plat _____
5. Private Claims _____

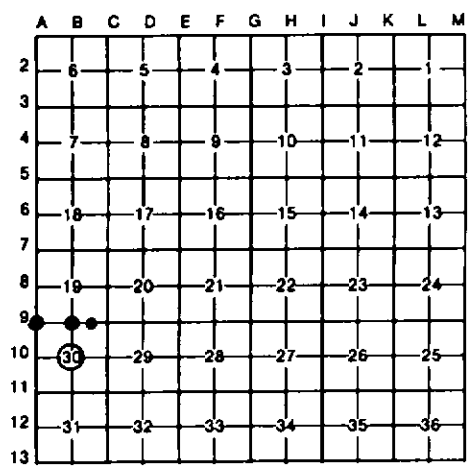

I, CARL F. ROSER , in a field survey on JULY 6, , 19 87 , do hereby certify that under requirements of P.A. 74, Michigan P.A. of 1970, the corner points mentioned in lines 1 and 2 above were in conformance with regulations and rules therefore as required in the current manual of survey instructions of the United States Department of the Interior, Bureau of Land Management or by a decree of a Court of Law and/or that the corner points mentioned in lines 3, 4 and 5 above were in conformance with the rules of the Michigan Board of Land Surveyors or by a Decree of a Court of Law; established, re-established, monumented, re-monumented, recovered, found as expressed below:

NOTE: Not more than 4 corners, all in the same town and range, may be recorded on this certificate.

A. Description of original monument and accessories and/or subsequent restoration:

A-9	B-9	B-10	2
FD 5/8" IRON W/HAROLD BRUNING RLS CAP, IN MON BOX FOR NW COR S-30.	FD IRON FOR N 1/4 COR S-30 AS SET BY L.S.,L.CZUBAK. REPLACED IRON W/DNR MON. THIS FITS D.F. HOLDEN 1879 SUR DIST. TO CTR S-19 (HOLDEN = 2679.6', THIS SURVEY TO A COMPUTED CTR S-19 = 2677.1±).	FD IRON W//L.CZUBAK RLS CAP, FLUSH WITH B.TOP; FOR CTR OF S-30. COR IS 2 1/2'± S OF CTR OF B.TOP (E-W) CO. RD.	ESTABLISHED NW COR OF NE 1/4 -NE 1/4 OF S-30, PER STANDARD BLM INSTRUCTIONS. E-W RANDOM IS 31.5' N.

B. Description of corner evidence found and/or method applied in restoring or reestablishing corner:

A-9	B-9	B-10	2
FD 5/8" IRON W/HAROLD BRUNING RLS CAP, IN MON BOX FOR NW COR S-30.	FD IRON FOR N 1/4 COR S-30 AS SET BY L.S.,L.CZUBAK. REPLACED IRON W/DNR MON. THIS FITS D.F. HOLDEN 1879 SUR DIST. TO CTR S-19 (HOLDEN = 2679.6', THIS SURVEY TO A COMPUTED CTR S-19 = 2677.1±).	FD IRON W//L.CZUBAK RLS CAP, FLUSH WITH B.TOP; FOR CTR OF S-30. COR IS 2 1/2'± S OF CTR OF B.TOP (E-W) CO. RD.	ESTABLISHED NW COR OF NE 1/4 -NE 1/4 OF S-30, PER STANDARD BLM INSTRUCTIONS. E-W RANDOM IS 31.5' N.

C. Description of monument for corner and accessories established to perpetuate locating the position of the corner:

A-9	B-9	B-10	2
FD 5/8" IRON W/CAP #10681, IN MON BOX.	FD 1/2" IR BY RLS L.CZUBAK; ADDED DNR MON & CED POST.	FD IR W/RLS CAP #12581.	DROVE 5/8" X 34" REROD W/RLS CAP & SET CED POST W/LOC TAG.
SET CED POST W/	#10" MAP CLP 5 N30°E 45.61'	7" J PINE N38°E 46.64'	14" CHERRY N70°E 45.5'
LOC TAG. EAST 33'	* 7" W PINE S70°E 17.11'	11" MAPLE S46°E 74.89'	2" R OAK S38°E 7.0'
12" R PINE N45°E 89.39'	* 4" W PINE S40°W 34.07'	NE COR CONC BLOCK FDN OF	1" W OAK N78°W 15.5'
POWER POLE S60°E 82.78'	2" R OAK N70°W 4.66'	CHURCH S48°W 79.42'	FD 1" PIPE BY T.NOLAN
33" MAPLE S30°E 59.43'	FD 1" PIPE BY T. NOLAN	14" R PINE N44°W 56.71'	(1926) N07°59'W 31.51'
CTR 6"X6" TEL	(1926) N08°50'12"W 63.53'		
RISER S55 W 30.93'		SET CED POST	
CTR N-S 20' BIT RD DUE E 6'	*=L.S., L.CZUBAK WITS	W/LOC TAG NORTH 33'±	

Signed by Carl F. Roser 8-29-88 Date _____

Surveyor's Michigan License No. 12028

STATE OF MICHIGAN
CARL F. ROSER
LAND SURVEYOR
No. 12028
REGISTERED LAND SURVEYOR

FORM APPROVED BY MICHIGAN STATE BOARD OF LAND SURVEYORS, JAN. [illegible] REVISED JAN. [illegible]