LAND CORNER RECORDATION CERTIFICATE

Filing Requirement of Act 74, Mich. P.A. 1970

For corners in
BENZIE
(County)

	Located In:	Corner Code ##
1. Public Land Survey	T 26N R 13W	F-9
	T ___ R ___	
	T ___ R ___	
	T ___ R ___	
2. Property Controlling	S 28 T ___ R ___	2
in Section	S ___ T ___ R ___	
3. Miscellaneous	S 28 T ___ R ___	662.6-W G-9
Property in Sec.	S 28 T ___ R ___	662.6-E F-9

Filed 8/7/89 RW

Register of Deeds Stamp & File Number

4. Lot No. _____ , Recorded Plat _____
5. Private Claims _____

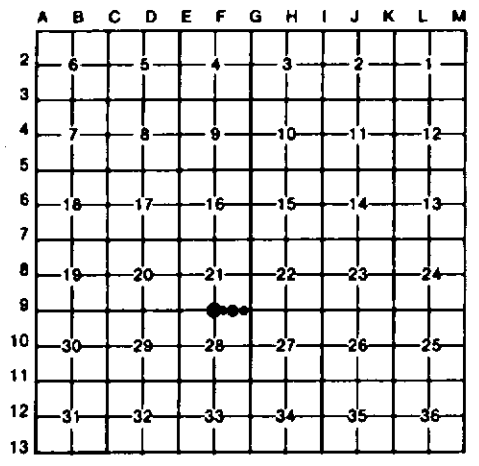

I, CARL F. ROSER, in a field survey on JUNE 30, 19 87, do hereby certify that under requirements of P.A. 74, Michigan P.A. of 1970, the corner points mentioned in lines 1 and 2 above were in conformance with regulations and rules therefore as required in the current manual of survey instructions of the United States Department of the Interior, Bureau of Land Management or by a decree of a Court of Law and/or that the corner points mentioned in lines 3, 4 and 5 above were in conformance with the rules of the Michigan Board of Land Surveyors or by a Decree of a Court of Law; established, re-established, monumented, re-monumented, recovered, found as expressed below:

NOTE: Not more than 4 corners, all in the same town and range, may be recorded on this certificate.

A. Description of original monument and accessories and/or subsequent restoration:

F-9	2	662.6-W G9	662.6-E F9

B. Description of corner evidence found and/or method applied in restoring or reestablishing corner:

F-9	2	662.6-W G9	662.6-E F9
RE-ESTAB. N 1/4 COR S-28 MIDWAY & ON LINE BETW NE & NW COR'S OF S-28. APPROX CTR OF 2-TRK TRL RD; W & E.N.E., IS NORTH 150'± (PACED).	ESTAB'D THE NE COR OF W 1/2-NE 1/4 OF S-28 PER STANDARD BLM INSTRUCTIONS. COR FALLS IN OLD E-W B.WIRE FENCE ON GROUND.	ESTAB'D THE NW COR OF E 1/2 OF E 1/2 OF NE 1/4 OF S-28 PER STANDARD BLM INSTRUCTIONS. COR FALLS AT APPROX INTERSEC OLD B.WIRE FENCE (N-S-E-W) ON GROUND.	ESTABLISHED THE NE COR OF W 1/2 OF W 1/2 OF NE 1/4 OF S-28 PER STANDARD BLM INSTRUCTIONS. COR FALLS IN OLD E-W B.WIRE FN ON GROUND

C. Description of monument for corner and accessories established to perpetuate locating the position of the corner:

F-9			2			662.6-W G9			662.6-E F9		
SET DNR MON & CED POST			DROVE 5/8" X 34" REROD W/RLS			DROVE 5/8" X 34" REROD W/RLS			DROVE 5/8" X 34" REROD W/RLS		
2" W PINE	S32°W	9.25	CAP & SET CED POST W/LOC TAG.			CAP & SET CED POST W/LOC TAG.			CAP & SET CED POST W/LOC TAG.		
5" W PINE	N65°E	40.80	10" W PINE	N52°E	28.87	5" OAK	N10°E	3.55	14" W PINE	N30°E	12.87
5" W PINE	N44°W	67.80	10" TW BEECH	S44°E	27.11	6" W PINE	N70°W	23.22	12" W PINE	S68°E	3.49
24" (1/2 SHELL)			6" OAK	S74°W	20.74	8" MAPLE	S36°W	29.30	12" TW MAPLE	N44°W	24.02
W PINE STP	N05°W	8.90	FD WELL PT	S85°50'E	7.97	FD LG R.R.IR	S88°30'E	2.68	FD WELL PT	S65°54'E	17.36
						DROVE 5/8"X34" REROD & SET CED POST	S89°34'53"E	266.61			

Signed by Carl F. Roser 8-29-88 Date _____

Surveyor's Michigan License No. 12028

STATE OF MICHIGAN
CARL F. ROSER
LAND SURVEYOR
No. 12028
REGISTERED LAND SURVEYOR

FORM APPROVED BY MICHIGAN STATE BOARD OF LAND SURVEYORS JULY 22, 1971
REVISED FEBRUARY 1, 1983