

LAND CORNER RECORDATION CERTIFICATE


Filing Requirement of Act 74, Mich. PA 1970

For Corners In: Benzie (County)	Located In	Corner Code #
1. Public Land Survey	T _____ R _____	_____
2. Property Controlling in Section	S 5 T 26N R 13W	CEE 1/64
3. Miscellaneous Property in Section	S 6 T 26N R 13W	10
	S _____ T _____ R _____	_____
	S _____ T _____ R _____	_____
4. Lot No: _____	Recorded Plat: _____	
5. Private Claims: _____		

Register of Deeds Stamp & File Number

I, Craig W. McVean, in a field survey on Aug 4, 1998 do hereby state that under requirements of PA 74, Michigan PA of 1970, the corner points mentioned in lines 1 and 2 above were in conformance with regulations and rules therefore as required in the current manual of survey instructions of the United States Department of the Interior, Bureau of Land Management or by a decree of a Court of Law and/or that the corner points mentioned in lines 3, 4 and 5 above were in conformance with the rules of the Michigan Board of Land Surveyors or by a Decree of a Court of Law; established, re-established, monumented, recovered, found as expressed below:

NOTE: Not more than 2 corners, all in the same town and range, may be recorded on this certificate.

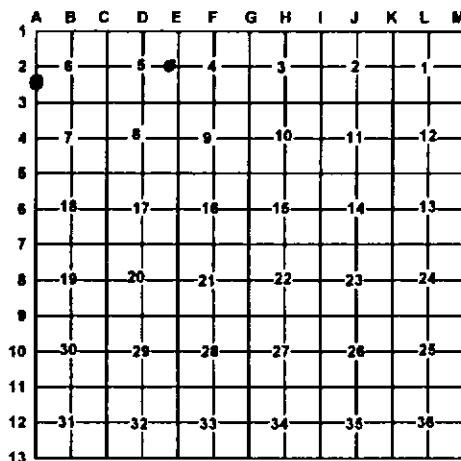

A. Description of original monument and accessories and/or subsequent restoration:

CEE - 1/64 - None

10 - DNR Survey - Project # 71 - 6 - 1971
FND. Well point

B. Description of corner evidence found and/or method applies in restoring or re-establishing corner:

CEE - 1/64 Cor. - Sec. 5 - Set 2" Alum. Cap on 5/8" x 34" Rebar per Standard BLM procedure. Remains of down barb-wire fence E-W is 13' ± 3' N.

10 - S 1/16 Cor. between Sec. 6, T26N, R13W and Sec. 1, T26N, R14W. FND. 1 1/2" I.D. Well screen point with white crockery and broken clearing glass around. Added 1/2" x 14" Rebar inside. N-S fence remains. Monument is 4' S. of CL. E-W Sand Rd. Fits closely, split distance, between A-2 & A-3. Well point is accepted as the best available evidence of the corner.

C. Description of monument for corner and accessories established to perpetuate locating the position of the corner:

CEE - 1/64 - 2" Alum. Cap on 5/8" x 34" Rebar
N61°W 16.37' to N&T in S. Side Tw. 14" S. Maple
N3°E 32.58' to N&T in E. Side Tw. 13" S. Maple
S79°E 64.18' to N&T in N. Side 6" S. Maple
S12°E 39.77' to N&T in E. Side 2" Blue Spruce
Set blue Carsonite post 1' NW

10 - 1/2" Rebar in 1 1/2" I.D. Well screen point
S63°W 18.75' to N&T in S. Side 6" S. Maple
N11°W 26.22' to N&T in W. Side 8" S. Maple - Clp. 4
N33°E 64.14' to N&T in SE. Side 12" R. Pine
S16°E 69.17' to N&T in E. Side 10" R. Pine
Set blue Carsonite 10' S



Signed by: Craig W. McVean

Date: 10/6/1998

Surveyor's Michigan License No.: 39088