

MAR 19 2000

LAND CORNER RECORDATION CERTIFICATE
Filing Requirement of Act 74, Mich. P.A. 1970 LIBER 2 PAGE 265

SECTION

For corners in

<u>Benzie</u> (County)	Located In:	Corner Code #
1. Public Land Survey	T <u>26N R 13W</u>	<u>E-5(Inland)</u>
	T _____ R _____	_____
	T _____ R _____	_____
	T _____ R _____	_____
2. Property Controlling in Section	S _____ T _____ R _____	_____
	S _____ T _____ R _____	_____
3. Miscellaneous Property in Sec.	S _____ T _____ R _____	_____
	S _____ T _____ R _____	_____

STATE OF MICHIGAN
BENZIE COUNTY
RECORDED
5 JAN 2000 3:27:41 PM
MICHELLE R. GRAY
REGISTER OF DEEDS
PAGES one

Register of Deeds Stamp & File Number

4. Lot No. _____, Recorded Plat _____
5. Private Claims _____

I, David T. Rowe, in a field survey on October 20, 1999 do hereby state that under requirements of P.A. 74, Michigan P.A. of 1970, the corner points mentioned in lines 1 and 2 above were in conformance with regulations and rules therefore as required in the current manual of survey instructions of the United States Department of the Interior, Bureau of Land Management or by a decree of a Court of Law and/or that the corner points mentioned in lines 3, 4 and 5 above were in conformance with the rules of the Michigan Board of Land Surveyors or by a Decree of a Court of Law; established, re-established, monumented, recovered, found as expressed below:

NOTE: Not more than 2 corners, all in the same town and range, may be recorded on this certificate.


A	B	C	D	E	F	G	H	I	J	K	L	M
1												
2	6		5		4		3		2		1	
3												
4	7		8		9		10		11		12	
5				●								
6	18		17		16		15		14		13	
7												
8	19		20		21		22		23		24	
9												
10	30		29		28		27		26		25	
11												
12	31		32		33		34		35		36	
13												

Ratified by Peer Group
In accordance with P.A. 345
Chairman [Signature]
Date 11/9/1999

A. Description of original monument and accessories and/or subsequent restoration:
E-5: Corner Common to Sections 8, 9, 16 and 17:
G.L.O. Notes: 1839 Set Post. 11" Sugar N54°W 141ks., 7" Birch S76°E 231ks.
County Records: 1880 D. Holden, Surveyors Record I, page 120, Set from original bearings.
1939 C. Cade, Iron stake set in centerline US-31
1976 G. DelaMater, iron f.d. in centerline US-31
1982 C. Roser, L. I, page 168, f.d. 1" iron pipe in Monument box 2.7'N of centerline US-31 and 7' W. of N-S gravel road. T. Pole N27°E 78.08', 24" Maple stump N45°E 56.82, 16" Apple S35°W 57.95'.

B. Description of corner evidence found and/or method applied in restoring or reestablishing corner:
E-5: Corner Common to Sections 8, 9, 16 and 17:
1999 Fd. 1 1/2" o.d. iron pipe in a monument box 2.8'N of centerline US-31 and 7'W. of Centerline Hulbert Road. The Benzie County Peer Group accepted the position by Bruning as being the best evidence of a locally accepted corner.

C. Description of monument for corner and accessories established to perpetuate locating the position of the corner:
E-5: Corner Common to Sections 8,9, 16 and 17:
Iron pipe in monument box replaced with 3/4" i. d. galvanized 36" long iron pipe with a stamped brass cap in a monument box 2.8'N of centerline US-31 and 7'W. of centerline Hulbert Road.
Witnesses: S27°W 67.37' Fd. nail W. Face blazed twin 8" R. Pine
S53°W. 52.64' Fd. U.S.G.S. Bronze disk in concrete 1" above ground. Stamped TT 51S 1932
N35° W. 98.90' SE Corner of house at concrete block foundation
N26° E. 152.00' SW Corner Block Building

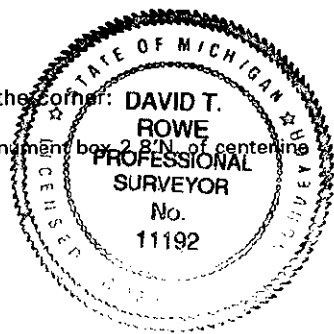

Signed by David T. Rowe
Surveyor's Michigan License No. 11192

Date Dec 17, 1999