

MAR 09 2000

LAND CORNER RECORDATION CERTIFICATE
Filing Requirement of Act 74, Mich. P.A. 1970

SECTION

LIBER 2 PAGE 274

STATE OF MICHIGAN
BENZIE COUNTY
RECORDED

12 JAN 2000 9:22:10 AM
MICHELLE R. GRAY
REGISTER OF DEEDS
PAGES one

Register of Deeds Stamp & File Number

For corners in

Benzie (County)	Located In:	Corner Code #
1. Public Land Survey	T 26N R 13W	E-6
	T R	
2. Property Controlling in Section	S T R	
	S T R	
3. Miscellaneous Property in Sec.	S T R	
	S T R	

4. Lot No. _____, Recorded Plat _____

5. Private Claims _____

I, Craig W. McVean, in a field survey on Aug. 11, 1997 do hereby state that under requirements of P.A. 74, Michigan P.A. of 1970, the corner points mentioned in lines 1 and 2 above were in conformance with regulations and rules therefore as required in the current manual of survey instructions of the United States Department of the Interior, Bureau of Land Management or by a decree of a Court of Law and /or that the corner points mentioned in lines 3, 4 and 5 above were in conformance with the rules of the Michigan Board of Land Surveyors or by a Decree of a Court of Law; established, re-established, monumented, recovered, found as expressed below:

NOTE: Not more than 2 corners, all in the same town and range, may be recorded on this certificate.

	A	B	C	D	E	F	G	H	I	J	K	L	M
1													
2		6		5		4		3		2		1	
3													
4		7		8		9		10		11		12	
5													
6		18		17		16		15		14		13	
7													
8		19		20		21		22		23		24	
9													
10		30		29		28		27		26		25	
11													
12		31		32		33		34		35		36	
13													

A. Description of original monument and accessories and/or subsequent restoration:

E-6 - GLO - Set 1/4 post - Alvin & Austin Burt - 1839
 Beech 11° S75°E 30 L.
 Beech 7° N87°W 21 L.
 - Co. Bk., P. 8 - C.P. Tuller - Sub. of Sec. 16 - 1900
 Found one Beech witness tree plain marked
 - Dwg. C.M. Cade - Set Mon., Sub. of Sec. 17 - 1939
 8" Cherry S74°E 3.0'
 8" Elm N58°W 34.0'
 4" Maple S73°30'W 20.9'

-LCRC - L. 1, P. 161 - C.F. Roser - 1982
 Fd. Sq. conc. Mon as estab. By Cade. Added cedar post w/ Loc. tag
 *17" Cherry S55°E 3.39'
 *9" Maple S70°W 20.4'
 9 Cherry S05°W 57.4'
 Cor. falls in approx. line w/ Trail Rd. to N & W
 & 47'± W of Trail Rd. to SE.
 *Cade Wits.


Ratified by Peer Group
 In accordance with P.A. 345
 Chairman [Signature]
 Date 11/2/1999

B. Description of corner evidence found and/or method applied in restoring or reestablishing corner:

E-6 - 1/4 Corner common to Sec.'s 16&17, T26N,R13W - FND. State of Mich. Brass Cap in 6"x 6" Conc. Tablet. Brass Cap is oriented S, not N. FND. rotted off 6" cedar post nearby. Position is just S. of 'Y' Gravel Rd. intersection. Brass Cap Monument accepted as the best available evidence of the position of the original corner.

C. Description of monument for corner and accessories established to perpetuate locating the position of the corner:

E-6 - State of Mich. Brass Cap in 6"x6" Conc. Tablet
 S2°W 57.76' to set N&T in W. Side 11" Cherry (CFR)
 S71°W 20.4' to blaze in face 9" dead Maple Stp. (Cade & CFR)
 S65°E 3.41' to fnd. nail in S. Side 13" Cherry (Cade & CFR)
 N45°E 87.80' to N&T in N. Side 10" W. Pine - scribed 'XBT'
 S14°W 60.65' to N&T in E. Side 7" W. Pine - scribed 'XBT'
 Set blue Carsonite post 1' S.
 Reset rotted off cedar post 1'± NW.

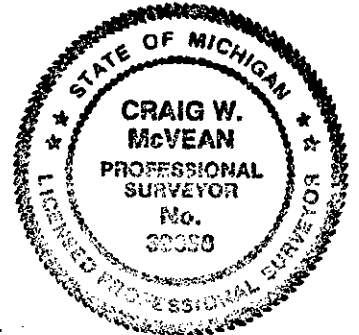

Signed by Craig W. McVean
 Surveyor's Michigan License No. 39088

Date 12/8/1999