SURVEY &
RE[illegible]N

MAR 0 9 2000

SECTION

LAND CORNER RECORDATION CERTIFICATE
Filing Requirement of Act 74, Mich. P.A. 1970

LIBER 2 PAGE 324

STATE OF MICHIGAN
BENZIE COUNTY
RECORDED

4 FEB 2000 1:09:27 PM
MICHELLE R. GRAY
REGISTER OF DEEDS
PAGES one

Register of Deeds Stamp & File Number

For corners in INLAND Township

BENZIE (County)

		Located In:	Corner Code #
1. Public Land Survey		T26N R13W	L-3
		T___ R___	
		T___ R___	
2. Property Controlling	S___	T___ R___	
in Section	S___	T___ R___	
3. Miscellaneous	S___	T___ R___	
Property in Sec.	S___	T___ R___	

4. Lot No. _____, Recorded Plat _____
5. Private Claims _____

I, JOHN F. KORR, JR., in a field survey on December 14, 19 99, do hereby certify that under requirements of P.A. 74, Michigan P.A. of 1970, the corner points mentioned in lines 1 and 2 above were in conformance with regulations and rules therefore as required in the current manual of survey instructions of the United States Department of the Interior, Bureau of Land Management or by a decree of a Court of Law and/or that the corner points mentioned in lines 3, 4 and 5 above were in conformance with the rules of the Michigan Board of Land Surveyors or by a Decree of a Court of Law; established, re-established, monumented, re-monumented, recovered, found as expressed below:

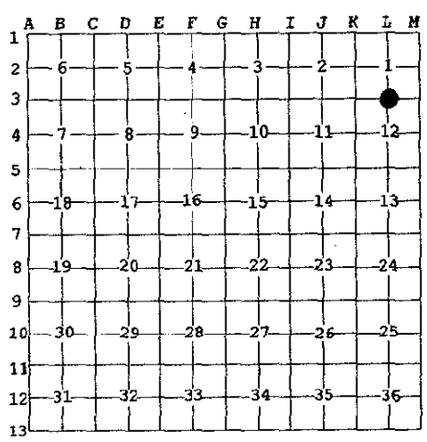

NOTE: Not more that 4 corners, all in the same town and range, may be recorded on this certificate.

A. Description of original monument and accessories and/or subsequent restoration:

1850 GLO - Survey - Set post for corner with two witnesses:
Beech 10" - N63°W - 33.00'; Beech 10" - S65°E -19.14'.

County Survey records No date -Rock, Book 2, Page 158.

1972 - Benzie Co. Road Commission - Draft L.C.R.C. form, Found old bolt w/ sq. Head witnessed by:
Maple 24" - N01°E - 40.01"; Maple 10" - S29°W - 39.27'; Beech 26" - S46°E - 50.90'.

1974 - Harold Bruning -Certificate of survey, recorded in Liber 1, Page 364, Found large stone & Iron bolt, Witnessed by: same as Benzie Co. Road Comm.

1974 - Harold Bruning -Certificate of survey, recorded in Liber 1, Page 385, Found large stone & Iron bolt, Witnessed by: same as Benzie Co. Road Comm. Also recorded an L.C. R. C. In Liber 1, Page 138 in 1975.

No Date - Survey by Perla-Stout, Iron Found Wit By: Tree 36" - N60°W - 74.35'; J. Pine 8" - S45°E - 63.53; Twin Tree w/blaze S50°W - 108.25.

1983 - Wm. B. Batzer - Survey in Liber 1, Page 775, Fd. Bolt on fence line North & 6 feet South of E-W Centerline of Co. Road, Witnessed by: Maple 36" - N76°E - 117.31'; Cherry 18" - N61°W - 74.35'; Tw. Cherry - S74 - ½°W - 108.21'; J. Pine 6" - S36°E - 63.50'. Also in 1977 a Certificate of Survey in Liber 3, Page 389.

1998 - Benzie Co. Road Commission - Found ½" Iron Rod & witnessed by:
Maple 30" - N00°W - 40.55"; Spruce 6" - N41°W - 54.41'; Maple 12" - S19°E - 37.08'; Maple 16" - S31°W - 39.25'.

1999 - M. Harris -Certificate of survey, recorded in Liber 2, Page 1127, Found Bolt w/ ½" Iron Rod 6 feet South of E-W Road, and found three witnesses of the Benzie Co., Road Commission.

B. Description of corner evidence found and/or method applied in restoring or reestablishing corner:

Found ½" X 18" Rebar over a 1" Sq, Head Bolt and large Rock as noted above in "A". In of Centerline of newly reconstructed County Road, Accepted as The Best Available evidence of the original Government corner.

C. Description of monument for corner and accessories established to perpetuate locating the position of the corner:

At the position of L-3, I set a Standard Benzie Co. Remonumentation Monument, & wit: by the following:
Fir 10" - N32°W - 48.77' - Spike set
Maple 24" - N07°E - 40.50' - Fd. Nail
Beech 24' - S40°E - 51.97' - Set Spike
Maple 16" - S34°W - 39.25' - Fd. Nail

STATE OF MICHIGAN
JOHN F. KORR JR.
LAND SURVEYOR
No. 24600
REGISTERED LAND SURVEYOR

Ratified by Peer Group
accordance with P.A. 345
Chairman [signature]
Date 11/11/99

Signed by [signature] Date 12/23/99
John F. Korr, Jr.
Surveyor's Michigan License No. 24600

FORM APPROVED BY MICHIGAN STATE BOARD OF LAND SURVEYORS, JAN. 28,
REVISED MAY 14,
REVISED JAN.,