

LAND CORNER RECORDATION CERTIFICATE
Filing Requirement of Act 74, Mich. P.A. 1970


For corners in

Benzie Located In: _____ Corner Code # _____
 (County)

1. Public Land Survey T _____ R _____
 T _____ R _____

2. Property Controlling S 16 T 26N R 13W CWSE 1/64
 in Section S _____ T _____ R _____

3. Miscellaneous S _____ T _____ R _____
 Property in Sec. S _____ T _____ R _____

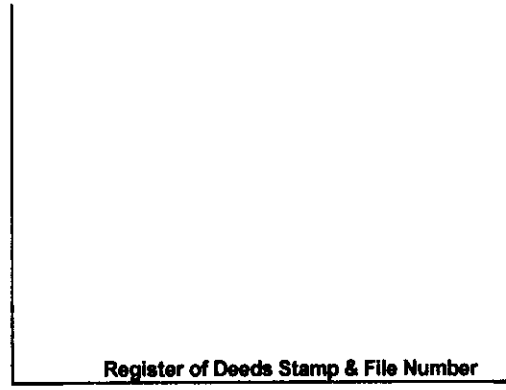

4. Lot No. _____, Recorded Plat _____

5. Private Claims _____

I, Craig W. McVean, in a field survey on Feb. 10, 19 98 do hereby state that under requirements of P.A. 74, Michigan P.A. of 1970, the corner points mentioned in lines 1 and 2 above were in conformance with regulations and rules therefore as required in the current manual of survey instructions of the United States Department of the Interior, Bureau of Land Management or by a decree of a Court of Law and /or that the corner points mentioned in lines 3, 4 and 5 above were in conformance with the rules of the Michigan Board of Land Surveyors or by a Decree of a Court of Law; established, re-established, monumented, recovered, found as expressed below.

	A	B	C	D	E	F	G	H	I	J	K	L	M
1													
2	6		5		4		3		2		1		
3													
4	7		8		9		10		11		12		
5													
6	18		17		16		15		14		13		
7													
8	19		20		21		22		23		24		
9													
10	30		29		28		27		26		25		
11													
12	31		32		33		34		35		36		
13													

NOTE: Not more than 2 corners, all in the same town and range, may be recorded on this certificate.

A. Description of original monument and accessories and/or subsequent restoration:
CWSE 1/64 - None, not previously set.

B. Description of corner evidence found and/or method applied in restoring or reestablishing corner:
CWSE 1/64 - SE Cor. of W 1/2 of W 1/2 of N 1/2 of SE 1/4, Sec.16, T26N,R13W. - Set 2" Alum. Cap on 5/8"x 34" Rebar per Standard BLM procedure. E-W Fence is 9' N.

C. Description of monument for corner and accessories established to perpetuate locating the position of the corner:
CWSE 1/64 - 2" Alum. Cap on 5/8"x 34" Rebar
 S87°E 6.24' to N&T in N. Side 10" W. Pine
 S28°E 8.98' to N&T in SW. Side 8" W. Pine
 S48°W 23.74' to N&T in SE. Side 3" W. Pine
 N88°W 16.62' to N&T in N. Side 8" W. Pine
 Set blue Carsonite post 1' SW.



Signed by Craig W. McVean Date 3/29/2000
 Surveyor's Michigan License No. 39088