


LAND CORNER RECORDATION CERTIFICATE

Filing Requirement of Act 74, Mich. PA 1970

For Corners In: <u>Benzie</u> (County)	Located In	Corner Code #
1. Public Land Survey	T <u>26N</u> R <u>13W</u>	<u>L10</u>
	T _____ R _____	_____
2. Property Controlling in Section	S _____ T _____ R _____	_____
	S _____ T _____ R _____	_____
3. Miscellaneous Property in Section	S _____ T _____ R _____	_____
	S _____ T _____ R _____	_____

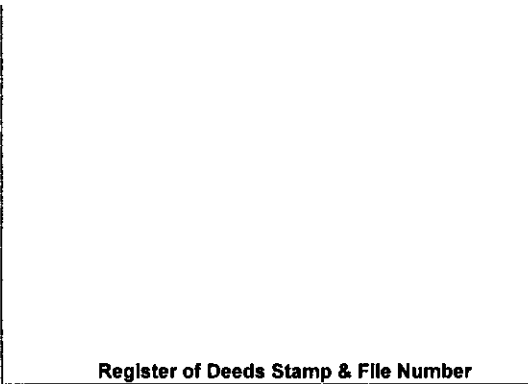

Register of Deeds Stamp & File Number

4. Lot No: _____ Recorded Plat: _____

5. Private Claims: _____

I, Craig W. McVean, in a field survey on Sept. 2, 1998 do hereby state that under requirements of PA 74, Michigan PA of 1970, the corner points mentioned in lines 1 and 2 above were in conformance with regulations and rules therefore as required in the current manual of survey instructions of the United States Department of the Interior, Bureau of Land Management or by a decree of a Court of Law and/or that the corner points mentioned in lines 3, 4 and 5 above were in conformance with the rules of the Michigan Board of Land Surveyors or by a Decree of a Court of Law; established, re-established, monumented, recovered, found as expressed below:

NOTE: Not more than 2 corners, all in the same town and range, may be recorded on this certificate.

	A	B	C	D	E	F	G	H	I	J	K	L	M
1													
2	6		5		4		3		2		1		
3													
4	7		8		9		10		11		12		
5													
6	18		17		16		15		14		13		
7													
8	19		20		21		22		23		24		
9													
10	30		29		28		27		26		25		
11													
12	31		32		33		34		35		36		
13													

A. Description of original monument and accessories and/or subsequent restoration:

L10- C.P. Tuller- 1896 – Sec. 25 Survey
 Set cedar post
 Birch 17° S62°W 18 4/12 ft.
 W. Pine 40° N18°E 10 ft.
 - Unrecorded survey- Grand Traverse Surveys #
 93-5632- N. Livasy- set Iron –1993



B. Description of corner evidence found and/or method applies in restoring or re-establishing corner:

L10- C. ¼ Sec. 25- FND. 3" x 1.1' Long cedar post bottom w/ axed point in swampy ground down 0.4' per C.P. Tuller's W. Pine BT Stp. Tuller's notes indicate that he set this post midway between K9 & M9. Tuller's Post position is 1.53' S. & 3.8'E of the calculated ¼ Line intersection position and is accepted as the best available evidence of the position of the corner.

Reference Pt.- FND. Capped N. Livasy-½" Iron # 31611- N31°41'W 38.92' of Tuller's position. Capped Iron not accepted as L10 since Tuller indicates he had original evidence to the E & W to set his position.

C. Description of monument for corner and accessories established to perpetuate locating the position of the corner:

L10- Replaced cedar post bottom w/ 4" DNR Alum. Cap on 1" x 36" long galv. Iron pipe. Reset cedar post bottom on N. side as a memorial. Set Blue Carsonite Post 1' NW.
 N18°E 11.54' to set ½" x 24" rebar in CL. remains 40" W. Pine Stp. (CPT)
 N15°E 23.25' to set N & T in E. side 6" cedar
 N76°E 27.72' to set N & T in SE side 5" cedar
 S35°W 30.70' to set N & T in NW side 16" W. Pine
 S79°W 29.72' to set N & T in N side 16" W. Pine
 N31°41'W 38.92' to ½" CIR #31611 – Ref. Pt.

Signed by: Craig W. McVean
 Surveyor's Michigan License No.: 39088

Date: 3/29/2000