


LAND CORNER RECORDATION CERTIFICATE

Filing Requirement of Act 74, Mich. PA 1970

For Corners In: Benzie Located In _____ Corner Code # _____
(County)

- | | | | | | |
|--------------------------------------|-------------|--------------|--------------|--|----------|
| 1. Public Land Survey | T _____ | R _____ | | | |
| | T _____ | R _____ | | | |
| 2. Property Controlling in Section | S <u>25</u> | T <u>26N</u> | R <u>13W</u> | | <u>1</u> |
| | S <u>25</u> | T <u>26N</u> | R <u>13W</u> | | <u>2</u> |
| 3. Miscellaneous Property in Section | S _____ | T _____ | R _____ | | |
| | S _____ | T _____ | R _____ | | |

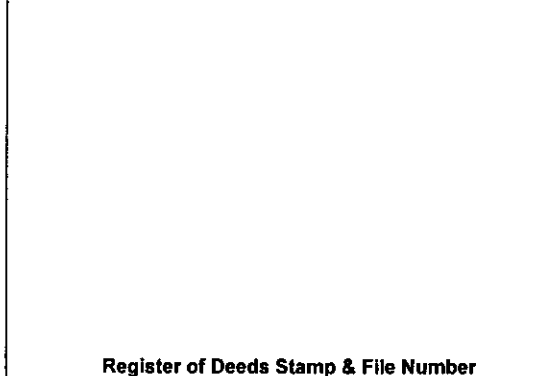

4. Lot No: _____ Recorded Plat: _____

5. Private Claims: _____

I, Craig W. McVean, in a field survey on Aug. 26, 1998 do hereby state that under requirements of PA 74, Michigan PA of 1970, the corner points mentioned in lines 1 and 2 above were in conformance with regulations and rules therefore as required in the current manual of survey instructions of the United States Department of the Interior, Bureau of Land Management or by a decree of a Court of Law and/or that the corner points mentioned in lines 3, 4 and 5 above were in conformance with the rules of the Michigan Board of Land Surveyors or by a Decree of a Court of Law; established, re-established, monumented, recovered, found as expressed below:

NOTE: Not more than 2 corners, all in the same town and range, may be recorded on this certificate.

	A	B	C	D	E	F	G	H	I	J	K	L	M
1													
2	6		5		4		3		2		1		
3													
4	7		8		9		10		11		12		
5													
6	18		17		16		15		14		13		
7													
8	19		20		21		22		23		24		
9											●	●	
10	30		29		28		27		26		25		
11													
12	31		32		33		34		35		36		
13													

A. Description of original monument and accessories and/or subsequent restoration:

1 - None

2 - Rec. Survey - L. 2 P. 453- R. M. Harris 1994- set PK Nail



B. Description of corner evidence found and/or method applies in restoring or re-establishing corner:

1 - W 1/16 Cor. Common to Sec. 24 & 25- Set 2" Alum. Cap on 5/8" x 34" Rebar in CL. of E-W Bit. Rd. per standard BLM procedure.

2 - E 1/16 Cor. Common to Sec. 24 & 25 - FND. PK nail midway and on line between L9 & M9. Replaced PK nail w/ 2" Alum. Cap on 5/8" x 34" Rebar - 1' south of Phy CL. E-W Bit. Rd. Also found a 3/4" iron pipe 0.5' N & 1.25' W and another PK nail (Harris) 1.89' WNWly that were not accepted as the corner.

C. Description of monument for corner and accessories established to perpetuate locating the position of the corner:

1 - 2" Alum. Cap on 5/8" x 34" Rebar
South 33.00' to set 2" Alum. Cap on 5/8" x 34" Rebar on line w/ Blue Carsonite Post w/ Loc. Tag
N34°W 54.51' to N & T in NE side 3" W. Pine
S34°W 49.38' to N & T in W side 21" R. Pine
N43°E 72.03' to N & T in NW side 6" W. Pine
S42°E 99.10' to NE Cor. Alum. Siding on HSE. #20277

2 - 2" Alum. Cap on 5/8" x 34" Rebar
North 33.02' to PS Cap #28417 on 1/2" Rebar
South 33.00' to set 2" A.C. on 5/8" x 34" Rebar on line w/ Blue Carsonite Post w/ Loc. Tag.
S50°W 76.76' to N & T in NW side 13" R. Pine
N50°E 181.30' to SW Cor. Blk. FNDT. HSE #20788
N45°W 46.49' to N & T in SW side UP

Signed by: Craig W. McVean
Surveyor's Michigan License No.: 39088

Date: 3/29/2000