


LAND CORNER RECORDATION CERTIFICATE

Filing Requirement of Act 74, Mich. PA 1970

| | | |
|---------------------------------------|-------------------------------------|---------------|
| For Corners In: Benzie (County) | Located In | Corner Code # |
| 1. Public Land Survey | T <u>26N</u> R <u>13W</u> <u>D7</u> | |
| | T _____ R _____ | |
| 2. Property Controlling in Section | S _____ T _____ R _____ | |
| | S _____ T _____ R _____ | |
| 3. Miscellaneous Property in Section | S _____ T _____ R _____ | |
| | S _____ T _____ R _____ | |
| 4. Lot No: _____ | Recorded Plat: _____ | |
| 5. Private Claims: _____ | | |

Register of Deeds Stamp & File Number

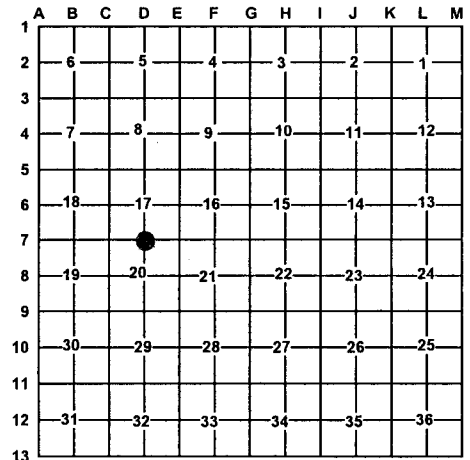

I, Craig W. McVean, in a field survey on June 13, 2007 do hereby state that under requirements of PA 74, Michigan PA of 1970, the corner points mentioned in lines 1 and 2 above were in conformance with regulations and rules therefore as required in the current manual of survey instructions of the United States Department of the Interior, Bureau of Land Management or by a decree of a Court of Law and/or that the corner points mentioned in lines 3, 4 and 5 above were in conformance with the rules of the Michigan Board of Land Surveyors or by a Decree of a Court of Law; established, re-established, monumented, recovered, found as expressed below:

NOTE: Not more than 2 corners, all in the same town and range, may be recorded on this certificate.

A. Description of original monument and accessories and/or subsequent restoration:

- | | |
|--|---|
| <p><u>D7</u> – 1839 – GLO – Alvin & Austin Burt Set Qr. Section post.</p> <ul style="list-style-type: none"> 1) Sugar 14" S40°E 14 Links; 2) Sugar 11" N41°W 7 Links - 1870 – County Surveyor Records – George Steele – reset corner from original BT's, old trees nearly extinct (NBT) 3) Sugar 12" S26½°W 72 Links 4) Sugar 12" N37°E 40 Links - 1939 – Department of Conservation Survey Map – C. M. Cade – Set concrete monument. 5) Poplar 6" N68°W 13.0' 6) Maple 2" S32°E 16.7' 7) Maple 2" S25°W 22.8' | <ul style="list-style-type: none"> - 1982 – LCRC – L. 1, p. 163 and field notes – Carl F. Roser Found and accepted square concrete monument (Cade 1939) for S ¼ Corner, Sec. 17, buried 0.5' – LCRC; (Notes – Fd. Cade Mon. bent over, we adj. it to a st. line double across established SE Sec. 17 & fd. 1/8 Cor. to East.) 8) Maple 12" N30°E 16.0' 6) Maple 9" S35°E 17.8' 7) Maple 9" S20°W 23.0'; Center of E-W 2-track S ± 3'; 9) Set Cedar post with location tag N. 16.5' - 1982 – Unrecorded survey – H. R. Bruning – Same wits as Roser |
|--|---|

B. Description of corner evidence found and/or method applied in restoring or re-establishing corner:

- D7 – ¼ Corner common to Sections 17 & 20, T26N, R13W – Found a short ½" rebar over found 0.5' x 0.5' x 2.5' long square base of Cade's 1939 monument - 0.8' below ground. This being the bottom 2.5' of the 4' long Cade Concrete Monument. Fits Cade witnesses #6 & #7. No evidence of GLO or Steele's witnesses. Corner is 2' N. of centerline of E-W 2-track. Accepted found bottom portion of Cade concrete monument as the best available evidence of the position of the original corner.
- Reference Point – Fd. 4" State of Michigan brass cap on 0.5' x 0.5' x 1.5' long concrete square post that is N66°52'W 1.75' of 'D7'. This is the top ½ of the broken off 1939 Cade monument that was reset and used by Roser per his LCRC. Top ½ of Cade Monument not used as 'D7' in this survey. Removed top ½ of Cade mon. and replaced with spike.

C. Description of monument for corner and accessories established to perpetuate locating the position of the corner:

- D7 – Replaced bottom ½ of Cade Monument with 3" Benzie Co. Remon. Brass Cap on ¾" x 36" iron pipe encased in 4" x 36" concrete cylinder – Down 0.8'. Broke up bottom ½ of Cade Mon. and placed concrete pieces around Benzie Co. Monument as memorial.
- S19°W 22.90' to set Nail & Tag (N & T) at fd. nail in E. side Tw. 14" S. Maple (#7)
 - S38°E 16.52' to set N & T at fd. nail in W. side 16" R. Maple (#6)
 - N23°E 16.15' to set N & T at fd. nail in SE side 22" S. Maple (#8)
 - N54°W 20.53' to set N & T in NE side 4" S. Maple scribed 'XBT'
 - North 17.47' to fd. nail in E. side Cedar post with location tag (#9)
 - N66°52'W 1.75' to spike – Reference Point
 - South 33.0' to set 4" State of Michigan Brass Cap stamped "1/4 Cor. is 33.00' North" on 0.5' x 0.5' x 1.5' long concrete post (Top ½ of Cade Mon.) on line with Blue Carsonite Post.



Signed by: Craig W. McVean
 Surveyor's Michigan License No.: 39088

Date: 12/11/2007