

LAND CORNER RECORDATION CERTIFICATE

FILING REQUIREMENT OF ACT 74, MICH. P.A.1970

FOR CORNERS OF--:	LOCATED IN--:	CORNER CODE NUMBER
1. PUBLIC LAND SURVEY _____	T. 26 N. ● , R. 14 W. ●	H-1; H-2; H-3
2. PROPERTY CONTROLLING IN SECTION <u>3</u>	T. 26 N. ● , R. 14 W. ●	12
3. MISCELLANEOUS PROPERTY IN SECTION _____	T. _____ N. ● , R. _____ E. ●	
4. LOT NO. _____, RECORDED PLAT _____		
5. PRIVATE CLAIMS _____		

REGISTER OF DEEDS STAMP AND FILING NUMBER

I, Carl F. Roser do hereby certify that under requirements of P.A. 74, Michigan P.A. of 1970, the corner points mentioned in lines 1 and 2 above (identified with circles on index code diagram - over) were, in a field survey on July 10, 1975, established, re-established, monumented, re-monumented, recovered or restored as expressed below and in conformance with regulations and rules therefore as required in the current manual of survey instructions of the United States Department of the Interior, Bureau of Land Management or by a decree of a court of law. Furthermore, that the corner points mentioned in lines 3, 4 and 5 above were, in a field survey on _____ 19____, found, recovered, restored, established or re-established as expressed below and in conformance with the rules of the Michigan State Board of Registration for Land Surveyors or, by a Decree of a Court of law:

A. Description of original monument and accessories and of subsequent restoration:

C. (continued) 12 ^(S 1/4 on N-S 1/4 line)
Sec. 3
 Found 1/2" rerod & added cedar post w/loc. tag
 11" Sugar Maple N58°W 47.49
 16" Black Cherry N13°W 27.44

B. Description of corner evidence found and/or method applied in restoring or re-establishing corner:

- H-1 Found P.K. nail in blacktop road, by R.L.S. Bruning. Corner of record.
- H-2 Found 1/2" rerod w/R.L.S. cap #10681, Bruning, for center of Sec. 3; equals northwest corner of parcel "A".
- H-3 Found bottom portion of cast iron monument (top 0.65' sheared off), buried one foot in southerly edge of E-W narrow dirt road. Corner of record by R.L.S. Bruning.
- 12 Found 1/2" rerod w/R.L.S. cap #10681, H.R. Bruning,; equals SW corner of parcel "D".

C. Description of monument for corner and accessories established to perpetuate locating the position of the corner:

H-1 (N 1/4 Cor. ~ Sec. 3)	H-2 (ctr. Sec. 3)	H-3 (S 1/4 Cor., Sec. 3)
Found PK & replaced w/1-1/8"x18" iron rod.	Found 1/2" rerod & added cedar post w/loc. tag	Found bottom of cast iron monument (buried)
30" Maple S43°E 39.00	10" Hard Maple N12°W 48.01	18" Hemlock S68°E 26.81
24" Maple S66°E 34.42	6" Hard Maple S62°W 2.37	13" Maple S02°E 20.08
T. Pole S60°W 81.1	14" Black Cherry S13°W 24.78	9" Hemlock N16°E 37.95
RR Spike (Rd. PI) N60°W 12.09	W/E-W (barbed wire)	10" Maple S54°W 13.16
Set cedar post w/loc. tag S10°E 23'		


SIGNED BY Carl F. Roser DATE 7-16-75

SURVEYOR'S MICHIGAN REGISTRATION NO. 12028

FOR STATE AND UNITED STATES AGENCIES:

SIGNED BY _____ DATE _____
CHIEF OF SURVEY PARTY

APPROVED AND SIGNED BY _____ DATE _____
MICHIGAN REGISTERED LAND SURVEYOR

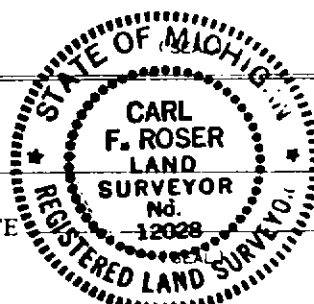

HOMESTEAD TOWNSHIP
BENZIE COUNTY

SURVEYOR'S MICHIGAN REGISTRATION NO. _____