

LAND CORNER RECORDATION CERTIFICATE
FILING REQUIREMENT OF ACT 74, MICH. P.A.1970

FOR CORNERS OF -: LOCATED IN -: CORNER CODE NUMBER
1. PUBLIC LAND SURVEY... T. 26 N., R. 14 W. F-13; G-13
2. PROPERTY CONTROLLING IN SECTION... T. S., R. E. W.
3. MISCELLANEOUS PROPERTY IN SECTION... T. S., R. E. W.
4. LOT NO., RECORDED PLAT
5. PRIVATE CLAIMS
REGISTER OF DEEDS STAMP AND FILING NUMBER

I, Carl F. Roser, do hereby certify that under requirements of P.A. 74, Michigan P.A. of 1970, the corner points mentioned in lines 1 and 2 above were, in a field survey on Jan. 10, 1979, established, re-established, monumented, re-monumented, recovered or restored as expressed below and in conformance with regulations and rules therefore as required in the current manual of survey instructions of the United States Department of the Interior, Bureau of Land Management or by a decree of a court of law.

A. Description of original monument and accessories and/or subsequent restoration:

- B. Description of corner evidence found and/or method applied in restoring or re-establishing corner:
F-13 Recovered broken piece of old large Auger Bit; believed to be a result of Frank S. Haswell (Co. Sur.) survey of So. line Sec's. 32 & 33, T26N-R14W, as recorded in Large Brown Surveyors Record, Pgs. 92 & 93, at Benzie Co. Reg. of Deeds. Auger fits Haswell's data.
G-13 Fd. 4''X2.5' Sq. Conc. Mon. (w/re-rod) buried in ctr. of E-W dirt road & in line with ctr. of old abandoned N-S rd. grade to north. Corner fits Frank S. Haswell (Co. Sur.) survey of So. Line Sec's. 32 & 33, T26N-R14W, as recorded in large Brown Surveyors Record, Pgs. 92 & 93, at Benzie Co. Reg. of Deeds.

C. Description of monument for corner and accessories established to perpetuate locating the position of the corner:

Table with 2 columns: F-13 and G-13. F-13 items include: Fd. Broken Auger Bit, 6'' Hemlock, 8'' Maple, 14'' Maple, Set Ced. Post w/Loc. Tag, Fd. 1'' pipe, Ctr. E-W dirt rd. G-13 items include: Fd. 4''X2.5' Sq. Concrete Mont. (buried), 12'' R. Pine, 8'' R. Pine, 10'' R. Pine, In Ctr of old Rd Bed Due N, Fd. Benzie Co. Mon. in Rd. inter. N-S-E-W.


SIGNED BY Carl F. Roser 2-12-79 DATE

SURVEYOR'S MICHIGAN REGISTRATION NO. 12028

FOR STATE AND UNITED STATES AGENCIES:

SIGNED BY CHIEF OF SURVEY PARTY DATE

APPROVED AND SIGNED BY MICHIGAN REGISTERED LAND SURVEYOR DATE

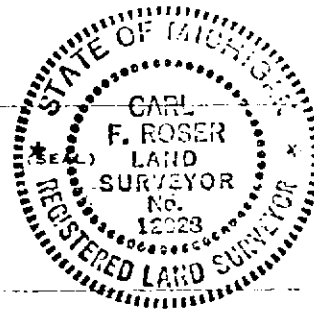

BENZIE COUNTY

SURVEYOR'S MICHIGAN REGISTRATION NO.