

RECEIVED

JUN 23 1997

LAND CORNER RECORDATION CERTIFICATE
Filing Requirement of Act 74, Mich. P.A. 1970

For corners in

BENZIE

(County)

Located In:

Corner Code #

1. Public Land Survey

T 26NR 14N I-1
T R
T R
T R

2. Property Controlling
In Section

S T R
S T R

3. Miscellaneous
Property In Sec.

S T R 1659' S. of I-1
S T R

Register of Deeds Stamp & File Number

4. Lot No. _____, Recorded Plat _____

5. Private Claims _____

I, CARL KIISKILA, in a field survey on AUGUST 14, 19 96 do hereby state that under requirements of P.A. 74, Michigan P.A. of 1970, the corner points mentioned in lines 1 and 2 above were in conformance with regulations and rules therefore as required in the current manual of survey instructions of the United States Department of the Interior, Bureau of Land Management or by a decree of a Court of Law and for that the corner points mentioned in lines 3, 4 and 5 above were in conformance with the rules of the Michigan Board of Land Surveyors or by a Decree of a Court of Law; established, re-established, monumented, recovered, found as expressed below:

NOTE: Not more than 2 corners, all in the same town and range, may be recorded on this certificate.

	A	B	C	D	E	F	G	H	I	J	K	L	M
1													
2	6		5		4		3		2		1		
3													
4	7		8		9		10		11		12		
5													
6	18		17		16		15		14		13		
7													
8	19		20		21		22		23		24		
9													
10	30		29		28		27		26		25		
11													
12	31		32		33		34		35		36		
13													

A. Description of original monument and accessories and/or subsequent restoration:


I-1 1659 S of I-1

G.L.O. INTERSECTED THE NORTH BOUNDARY 23 LINKS EAST OF SOUTH CORNER COMMON TO SECTIONS 34 AND 35. G.L.O. USED A 6" BEECH AS CORNER POST. 10" BEECH S44°E 13.2' NO EVIDENCE OF THIS G.L.O. CORNER OR BEARING TREE WAS FOUND. R. MAX HARRIS, RLS #25845, FOUND AND ACCEPTED A WELL POINT FOR THE NE COR OF SEC 3. R. MAX HARRIS REPLACED THE WELL POINT WITH A BENZIE CO. MARKER DEC. 14, 1973.

B. Description of corner evidence found and/or method applied in restoring or reestablishing corner:

I-1 1659 S of I-1

FOUND CAST IRON BENZIE CO. MARKER SET BY R. MAX HARRIS AND FITTING WITNESSES BY HAROLD R. BRUNING LIBER 1, PAGE 91, FOR CORNER COMMON TO SEC'S 2 & 3, T26N-R14W.

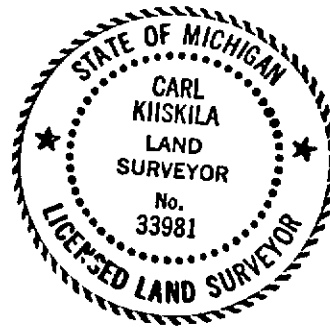

C. Description of monument for corner and accessories established to perpetuate locating the position of the corner:

I-1 1659 S of I-1

FD. CAST IRON BENZIE CO MON (TOP BROKEN OFF). DOVE 5/8" X 34" REROD W/PS CAP & SET CEDAR POST.
#13" MAPLE N65°W 56.76' 5" MAPLE N30°W 9.5'
#16" MAPLE N20°E 40.60' 5" MAPLE S60°E 3.1'
10" MAPLE S35°E 70.90' 7" S. MAPLE S05°W 6.6'
#18" MAPLE(CLP-4) S45°W 56.95'
SW COR S-35, T27N-R14W N88°58'W 14.77'
CTR DF GRAVEL RD SOUTH IS WEST 10'

§ = PS, H. BRUNING, 1974 WIT.

Signed by Carl T. Kiiskila

Date 4-9-97

Surveyor's Michigan License No. 33981