

SURVEY & REMONUMENTATION

APR 07 1998

LAND CORNER RECORDATION CERTIFICATE
Filing Requirement of Act 74, Mich. P.A. 1970

LIBER 2 PAGE 121

SECTION

STATE OF MICHIGAN
 BENZIE COUNTY
 RECORDED

For corners in

Benzie
 (County)

Located In:

Corner Code #

- | | | |
|---------------------------------------|---------------------------|-------------|
| 1. Public Land Survey | T <u>26N</u> R <u>14W</u> | <u>C-10</u> |
| | T _____ R _____ | _____ |
| | T _____ R _____ | _____ |
| | T _____ R _____ | _____ |
| 2. Property Controlling in Section | S _____ T _____ R _____ | _____ |
| | S _____ T _____ R _____ | _____ |
| 3. Miscellaneous Property in Sec. | S _____ T _____ R _____ | _____ |
| | S _____ T _____ R _____ | _____ |
| 4. Lot No. _____, Recorded Plat _____ | | |
| 5. Private Claims _____ | | |

19 Jan 1998 9:34:52 AM
 MICHELLE R. GRAY
 REGISTER OF DEEDS
 # PAGES one

Register of Deeds Stamp & File Number

I, John B. Smendzuik, in a field survey on December 20, 19 97, do hereby certify that under requirements of P.A. 74, Michigan P.A. of 1970, the corner points mentioned in lines 1 and 2 above were in conformance with regulations and rules therefore as required in the current manual of survey instructions of the United States Department of the Interior, Bureau of Land Management or by a decree of a Court of Law and/or that the corner points mentioned in lines 3, 4 and 5 above were in conformance with the rules of the Michigan Board of Land Surveyors or by a Decree of a Court of Law; established, re-established, monumented, re-monumented, recovered, found as expressed below:

A	B	C	D	E	F	G	H	I	J	K	L	M
2	6	5	4	3	2	1						
3												
4	7	8	9	10	11	12						
5												
6	18	17	16	15	14	13						
7												
8	19	20	21	22	23	24						
9												
10	30	29	28	27	26	25						
11												
12	31	32	33	34	35	36						
13												

NOTE: Not more than 4 corners, all in the same town and range, may be recorded on this certificate.

A. Description of original monument and accessories and/or subsequent restoration:

C-10: 1838: GLO set post - Sugar 11" N82°W 22 links and Sugar 11 and 12" East 21 links. Undated: Frank S. Haswell, Surveyor's Record 2, Page 106, says he set a 4" cedar post 4' deep with stones around it from original witnesses. Mr. Haswell also set the 1/16 corner south of this corner single proportionate between the adjacent section corners. Gordon Bonney did some retracement work in Section 29, of the Haswell survey, and reset this corner from some of the information from the Haswell survey. He did not look for or find the 1/16 corner south of here. 1995: John B. Smendzuik in a Certificate of Survey, Job No.: 95-4725, found the 1/16 corner south of this corner and doubled it over to here and dug a hole in the road. At 30" down, he found a circle of stones with wood remains in the center. He raised it to the surface with a iron and cap No. 30895. Gordon Bonney position is 0.35' to the Southwest.

B. Description of corner evidence found and/or method applied in restoring or reestablishing corner:


C-10: 1997: Found rebar with cap No. 30895 as per Smendzuik Certificate of Survey. The Benzie County Peer Group accepted the rebar as the perpetuation of the original GLO corner per Haswell's record.

Ratified by Peer Group
 In accordance with P.A. 345
 Chairman John B. Smendzuik
 Date 12/7/95

C. Description of monument for corner and accessories established to perpetuate locating the position of the corner:

C-10: Pulled the rebar with cap No. 30895 and set a 3" diameter Benzie County Remonumentation Program concrete monument with a brass cap in a monument box.

- 18" Maple S66°W 28.45' to found nail.
- 1/2 x 18" iron with cap No. 30895 West 33.00'.
- 12" Maple S88°E 39.10' to found nail.
- 10" Twin maple N52°E 39.73' to found nail.
- Monument box is in the centerline of Marshall Road and on an occupation line to the West.

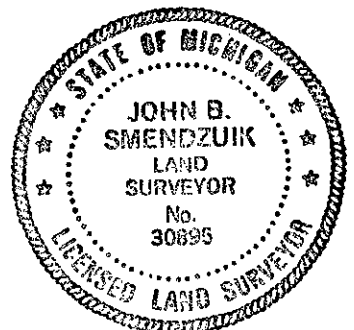

Signed by John B. Smendzuik

Date 1/10/98

Surveyor's Michigan License No. 30895