

MAR 9 2001

LAND CORNER RECORDATION CERTIFICATE
Filing Requirement of Act 74, Mich. P.A. 1970 LIBER 2 PAGE 259

SECTION

For corners in

<u>Benzie</u> (County)	Located In:	Corner Code #
1. Public Land Survey	T <u>26N R 14W</u>	<u>H-5(Homestead)</u>
—	T _____	_____
—	T _____	_____
—	T _____	_____
2. Property Controlling in Section	S _____	_____
—	S _____	_____
3. Miscellaneous Property in Sec.	S _____	_____
—	S _____	_____


4. Lot No. _____, Recorded Plat _____

5. Private Claims _____

STATE OF MICHIGAN
BENZIE COUNTY
RECORDED

5 JAN 2000 3:26:29 PM
MICHELLE R. GRAY
REGISTER OF DEEDS
PAGES one

Register of Deeds Stamp & File
Number

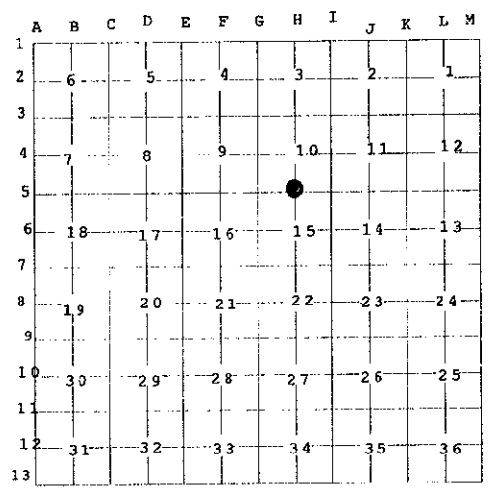

I, David T. Rowe, in a field survey on October 19, 1999 do hereby state that under requirements of P.A. 74, Michigan P.A. of 1970, the corner points mentioned in lines 1 and 2 above were in conformance with regulations and rules therefore as required in the current manual of survey instructions of the United States Department of the Interior, Bureau of Land Management or by a decree of a Court of Law and /or that the corner points mentioned in lines 3, 4 and 5 above were in conformance with the rules of the Michigan Board of Land Surveyors or by a Decree of a Court of Law; established, re-established, monumented, recovered, found as expressed below:

NOTE: Not more than 2 corners, all in the same town and range, may be recorded on this certificate.

A. Description of original monument and accessories and/or subsequent restoration:
H-5: ¼ Corner Common to Sections 10 and 15:
G.L.O. Notes: 1839 Set ¼" Sect. Post. 12" Sugar N4°W 37lks, 13" Beech S4°W 29lks.
County records: 1992 R.M. Harris, Fd. ½" iron rod 12.8' S. of center-line US-31. 6" Maple S50°E 45.6', 12" Twin Maple S03°E 34.25', 8" Maple S72°W 82.30', Evidence of old fence south.

B. Description of corner evidence found and/or method applied in restoring or reestablishing corner:
H-5: ¼ Corner Common to Sections 10 and 15:
1999 Fd. Broken off boat spike 13'S. of center-line US-31. Old fallen fence to South. The Benzie County Peer Group accepted the boat spike as being the best evidence of a locally accepted corner.

C. Description of monument for corner and accessories established to perpetuate locating the position of the corner:
H-5: ¼ Corner Common to Sections 10 and 15:
Boat spike replaced with ¾" i. d. galvanized 36" long iron pipe with a stamped brass cap in monument box 13'S. of center-line US-31.
Witnesses:
S03°E 34.33' Fd. Spike E. Face Blazed Twin 10" Maple
S52°E 61.10' Fd. Spike SW Face 12" Maple
S73°W 82.43' Fd. Spike N. Face Blazed 10" Maple
N05°E 65.50' Fd. Spike W. Face 12" J. Pine

Ratified by Peer Group
In accordance with P.A. 345
Chairman [Signature]
Date 11/9/1999



Signed by David T. Rowe
Surveyor's Michigan License No. 11192

Date 12/17/99