

LAND CORNER RECORDATION CERTIFICATE

Filing Requirement of Act 74, Mich. PA 1970

For Corners In:			
<u>Benzie</u>	Located In	Corner Code #	
(County)			
1. Public Land Survey	T <u>26N</u> R <u>14W</u>	<u>C-1</u>	
	T <u>27N</u> R <u>14W</u>	<u>C-13</u>	
2. Property Controlling in Section	S _____ T _____ R _____	_____	_____
	S _____ T _____ R _____	_____	_____
3. Miscellaneous Property in Section	S _____ T _____ R _____	_____	_____
	S _____ T _____ R _____	_____	_____


4. Lot No: _____ Recorded Plat: _____

5. Private Claims: _____

I, Craig W. McVean, in a field survey on Sept. 28, 1998 do hereby state that under requirements of PA 74, Michigan PA of 1970, the corner points mentioned in lines 1 and 2 above were in conformance with regulations and rules therefore as required in the current manual of survey instructions of the United States Department of the Interior, Bureau of Land Management or by a decree of a Court of Law and/or that the corner points mentioned in lines 3, 4 and 5 above were in conformance with the rules of the Michigan Board of Land Surveyors or by a Decree of a Court of Law; established, re-established, monumented, recovered, found as expressed below:

NOTE: Not more than 2 corners, all in the same town and range, may be recorded on this certificate.

Register of Deeds Stamp & File Number

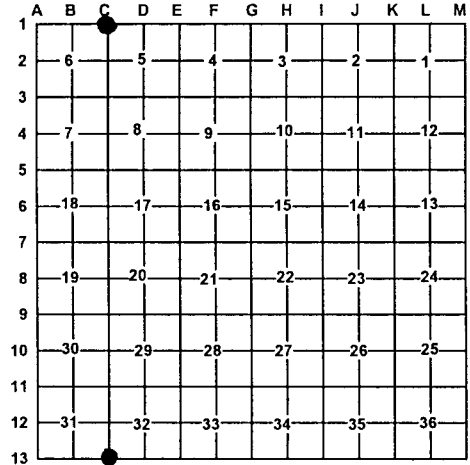

A. Description of original monument and accessories and/or subsequent restoration:

- | | |
|---|---|
| <p><u>C1 & C13</u> – GLO – Set post – Alvin Burt – 1839
 Spruce 10" N58½°W 54L.
 Cedar 6" N66°E 21L.</p> <p>- GLO – Sub – T26N, R14W – Alvin Burt - 1839
 Inter. N. Bdy. at Post
 Tamarack 6" S36°W 19 L.
 Spruce 7" S43°E 16 L.</p> <p>- CSR - Bk. 2, P. 12 – J. A. Pettitt
 Set Cedar post by original BT's</p> | <p>- Gourdie – Fraser notes – 1976 – G. DeLaMater
 7" Cedar East 6.45'
 16" W. Pine N8°E 36.66'
 5" Ash N45°W 16.27'
 Ced. Stp. N66°E 13.86' Rec.</p> |
|---|---|

B. Description of corner evidence found and/or method applied in restoring or re-establishing corner:

C1 & C13 – Standard Sec. corner common to Sec. 5 & 6, T26N, R14W and Sec. 31 & 32, T27N, R14W. – Fd. 1" O.D. x 2.15' long iron pipe in agreement with Gourdie – Fraser wit. notes. Searched and dug in swamp but couldn't find any conclusive evidence of GLO BT's or post or Pettitt's perpetuation. DeLaMater's notes indicate he had GLO Cedar Stp. BT's to reset pipe. All evidence of this cedar stp. was gone. By proportion N & S position would be 17'± N. of DeLaMater's pipe. 1" O.D. iron pipe by DeLaMater accepted as the best available evidence of the position of the original corner.

C. Description of monument for corner and accessories established to perpetuate locating the position of the corner:

C1 & C13 – Replaced 1" x 2.15' long iron pipe w/ 4" DNR Alum. Cap on 1" x 6" long galv. Iron pipe
 S87°E 6.54' to Fd. Nail in S side 8" Cedar (GFA)
 N14°E 36.62' to Fd. Nail in W side 16" W. Pine (GFA)
 S17°W 22.32' to set N & T in E side 8" Tamarack scribed 'XBT'
 S74°W 20.53' to set N & T in S side 5" Cedar scribed 'XBT'
 Set Blue Carsonite Post 1' NW



Signed by: Craig W. McVean Date: 8/27/2002
 Surveyor's Michigan License No.: 39088