

LAND CORNER RECORDATION CERTIFICATE

Filing Requirement of Act 74, Mich. PA 1970

| | | |
|--|---------------------------|---------------|
| For Corners In: <u>Benzie</u> (County) | Located In | Corner Code # |
| 1. Public Land Survey | T <u>26N</u> R <u>14W</u> | <u>I-2</u> |
| | T _____ R _____ | _____ |
| 2. Property Controlling in Section | S _____ T _____ R _____ | _____ |
| | S _____ T _____ R _____ | _____ |
| 3. Miscellaneous Property in Section | S _____ T _____ R _____ | _____ |
| | S _____ T _____ R _____ | _____ |


Register of Deeds Stamp & File Number

4. Lot No: _____ Recorded Plat: _____

5. Private Claims: _____

I, Craig W. McVean, in a field survey on April 15, 2005 do hereby state that under requirements of PA 74, Michigan PA of 1970, the corner points mentioned in lines 1 and 2 above were in conformance with regulations and rules therefore as required in the current manual of survey instructions of the United States Department of the Interior, Bureau of Land Management or by a decree of a Court of Law and/or that the corner points mentioned in lines 3, 4 and 5 above were in conformance with the rules of the Michigan Board of Land Surveyors or by a Decree of a Court of Law; established, re-established, monumented, recovered, found as expressed below:

NOTE: Not more than 2 corners, all in the same town and range, may be recorded on this certificate.

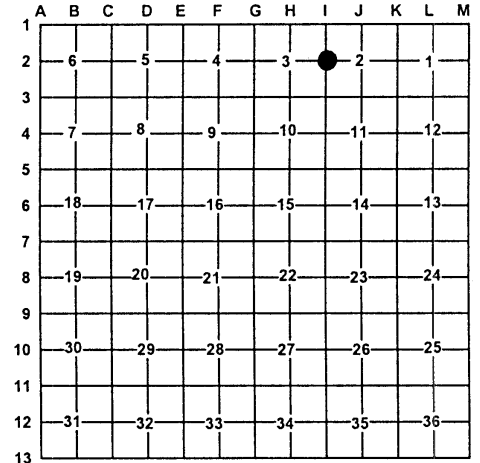

A. Description of original monument and accessories and/or subsequent restoration:

- I-2 - GLO - Set 1/4 Post - Alvin and Austin Burt - 1839
 - Beech 6" N15°E 8 L.
 - Beech 9" S19°W 31 L.
- CSR - Sm. Bk, p. 194 - J. A. Pettitt- 1897
 - Sec. 3. Survey shows corner.
- LCRC - L. 1, p. 91 - H. R. Bruning - 1974
 - Set 5/8" x 24" iron proportionate and on line between NE & SE corners. 5" Maple S18°E 46.81';
 - 20" B. Cherry S64°E 14.84'; 8" Basswood N6°W 87.90'
- LCRC - L. 1, p. 332 - C. Kiiskila - 1997
 - Fd. 5/8" re-rod. CTR. N-S winding dirt road is 360' ± west.
 - Add cedar post. 14" Basswood N5°W 87.62'; 18" Tri. B. Cherry S65°E 14.84'; 7" S. Maple S20°E 46.81'

B. Description of corner evidence found and/or method applied in restoring or re-establishing corner:

I-2 - 1/4 Corner common to Sec. 3 & 2 - Fd. 5/8" x 24" iron rebar of record per Bruning and Kiiskila. Fd. 5/8" rebar prop. to GLO distance between 'I-1' and 'I-3'. E-W 2-track is 10' N. 5/8" rebar accepted as a careful and faithful re-establishment of the position of the original corner.

C. Description of monument for corner and accessories established to perpetuate locating the position of the corner:

I-2 - Replaced 5/8" x 24" iron rebar with stamped 3" Benzie Co. Remon. Brass Cap on 3/4" x 36" iron pipe encased in 4" x 36" concrete cylinder. Face of Fd. Cedar post 0.6' WNW.
 Set Blue Carsonite Post 1' NE
 S65°E 14.87' to set N & T in SW side Tri. 21" B. Cherry (HRB, CK)
 S20°E 46.89' to Fd. nail in E side 11" S. Maple (HRB, CK)
 N9°W 87.70' to Fd. Nail in E. side 17" Basswood (HRB, CK)
 N58°W 46.74' to set N & T in NE side 8" S. Maple scribed 'XBT'



Signed by: Craig W. McVean
 Surveyor's Michigan License No.: 39088

Date: 5/9/2005