

LAND CORNER RECORDATION CERTIFICATE

Filing Requirement of Act 74, Mich. PA 1970

For Corners In: <u>Benzie</u> (County)	Located In	Corner Code #
1. Public Land Survey	T <u>26N</u> R <u>14W</u>	<u>I-4</u>
2. Property Controlling in Section	S _____ T _____ R _____	_____
3. Miscellaneous Property in Section	S _____ T _____ R _____	_____


Register of Deeds Stamp & File Number

4. Lot No: _____ Recorded Plat: _____

5. Private Claims: _____

I, Craig W. McVean, in a field survey on April 17, 2005 do hereby state that under requirements of PA 74, Michigan PA of 1970, the corner points mentioned in lines 1 and 2 above were in conformance with regulations and rules therefore as required in the current manual of survey instructions of the United States Department of the Interior, Bureau of Land Management or by a decree of a Court of Law and/or that the corner points mentioned in lines 3, 4 and 5 above were in conformance with the rules of the Michigan Board of Land Surveyors or by a Decree of a Court of Law; established, re-established, monumented, recovered, found as expressed below:

NOTE: Not more than 2 corners, all in the same town and range, may be recorded on this certificate.

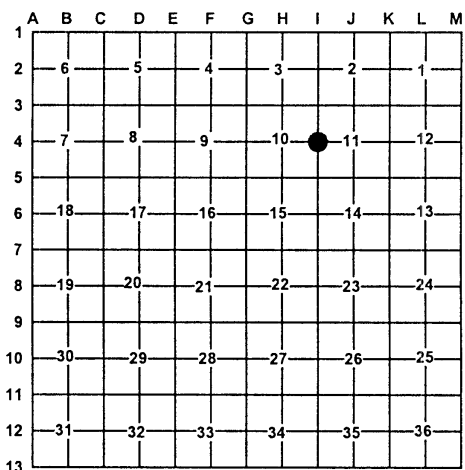

A. Description of original monument and accessories and/or subsequent restoration:
I-4 – GLO – Set ¼ Post – Alvin & Austin Burt – 1839
 Hemlock 12" N65°E 20 L.
 Beech 14" S40°W 25 L.

B. Description of corner evidence found and/or method applied in restoring or re-establishing corner:
I-4 – ¼ Corner common to Sec. 10 & 11 – Fd. ½" x 18" iron rebar on W. edge of Gravel Rd. on curve 27' ±W of centerline of Rd. from S. projected N. Old down E-W fence remains are 7'± N. No GLO evidence. ½" iron at single proportional position between '13' and '15'. ½ rebar accepted as a careful and faithful re-establishment of the position of the original corner.

C. Description of monument for corner and accessories established to perpetuate locating the position of the corner:
I-4 – Replaced ½" x 18" iron rebar with stamped 3" Benzie Co. Remon. Brass Cap on ¾" x 36" iron pipe encased in 4" x 36" Conc. Cylinder – Down 0.8'
 S87°W 42.78' to set N & T in N. side 20" B. Cherry
 N60°W 39.38' to fd. nail in NE side Tri. 10" R. Maple
 N33°W 54.35' to set N & T in E side 13" S. Maple
 S49°E 71.06' to set N & T in NE side 4" J. Pine
 Set Blue Carsonite Post with Loc. Tag S45°W 35'



Signed by: Craig W. McVean
 Surveyor's Michigan License No.: 39088

Date: 5/9/2005