

LAND CORNER RECORDATION CERTIFICATE

Filing Requirement of Act 74, Mich. PA 1970

For Corners In: <u>Benzie</u> (County)	Located In	Corner Code #
1. Public Land Survey	T <u>26N</u> R <u>14W</u> <u>K1</u>	
	T _____ R _____	
2. Property Controlling in Section	S _____ T _____ R _____	
	S _____ T _____ R _____	
3. Miscellaneous Property in Section	S _____ T _____ R _____	
	S _____ T _____ R _____	

Register of Deeds Stamp & File Number

4. Lot No: _____ Recorded Plat: _____

5. Private Claims: _____

I, Craig W. McVean, in a field survey on April 15, 2005 do hereby state that under requirements of PA 74, Michigan PA of 1970, the corner points mentioned in lines 1 and 2 above were in conformance with regulations and rules therefore as required in the current manual of survey instructions of the United States Department of the Interior, Bureau of Land Management or by a decree of a Court of Law and/or that the corner points mentioned in lines 3, 4 and 5 above were in conformance with the rules of the Michigan Board of Land Surveyors or by a Decree of a Court of Law; established, re-established, monumented, recovered, found as expressed below:

NOTE: Not more than 2 corners, all in the same town and range, may be recorded on this certificate.

	A	B	C	D	E	F	G	H	I	J	K	L	M
1													
2	6		5		4		3		2		1		
3													
4	7		8		9		10		11		12		
5													
6	18		17		16		15		14		13		
7													
8	19		20		21		22		23		24		
9													
10	30		29		28		27		26		25		
11													
12	31		32		33		34		35		36		
13													

A. Description of original monument and accessories and/or subsequent restoration:

K1 – GLO – Intersect N. Bdy. 32 L. E. of corner and 14" Tri. R. Maple S22°E 58.14'; 8" Tri. S. Maple S46°W 10.38';
 Set Post Cor. 1 & 2 – Alvin & Austin Burt – 1839 Ctr. N-S Sand Rd. W. 29'; SW S-36, T27N, R14W –
 Hemlock 36" S26°W 14 L. Sugar 12" S15°E 34 L. Set 1" x 48" galv. pipe with PS cap N89° 00'W 21.10'


- LCRC – L. 1, p. 335 – C. Kiiskila - 1997
 Set DNR Mon. and carsonite post with loc. tag at record U.S.G.L.O. dist. (21.1') East of re-est. Sec. Cor. 35 & 36, T27N, R14W, and on on line between SW & S ¼ of Sec. 36, T27N, R14W. 16" Tri. R. Maple N16°E 8.23';

B. Description of corner evidence found and/or method applied in restoring or re-establishing corner:

K1 – Closing corner common to Sec. 1 & 2, T26N, R14W – Fd. 4" DNR Alum. Cap on 1" galv. iron pipe per Kiiskila at record GLO distance East of standard corner. Accepted DNR Mon. as a careful and faithful re-establishment of the position of the original corner.

C. Description of monument for corner and accessories established to perpetuate locating the position of the corner:

K1 – 4" DNR Alum. Cap on 1" Galv. iron pipe
 N19°E 8.25' to fd. nail in West side triple 18" Red Maple (CK)
 S49°W 10.39' to fd. nail in SE side 14" triple Sugar Maple (CK)
 S20°E 58.14' to fd. nail in E side 16" triple Red Maple (CK)
 SE 0.6' to Fd. Blue Carsonite Post with Location tag
 West 21.10' to 'K13', T27N, R14W – a Benzie County Monument.

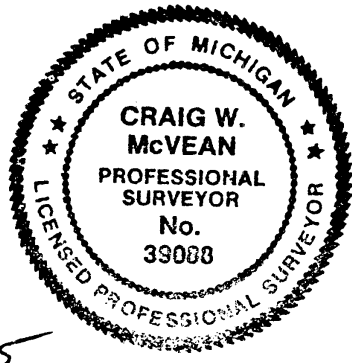

Signed by: *Craig W. McVean*
 Surveyor's Michigan License No.: 39088

Date: 5/9/2005