


LAND CORNER RECORDATION CERTIFICATE

Filing Requirement of Act 74, Mich. PA 1970

For Corners In:

Benzie			
(County)	Located In	Corner Code #	
1. Public Land Survey	T <u>26N</u> R <u>14W</u>	<u>H13</u>	
	T _____ R _____	_____	
2. Property Controlling in Section	S _____ T _____ R _____	_____	
	S _____ T _____ R _____	_____	
3. Miscellaneous Property in Section	S _____ T _____ R _____	_____	
	S _____ T _____ R _____	_____	

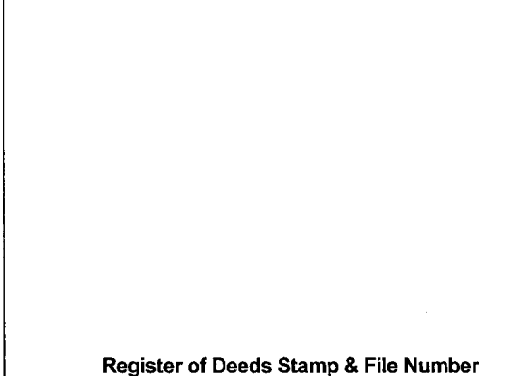

4. Lot No: _____ Recorded Plat: _____

5. Private Claims: _____

I, Craig W. McVean, in a field survey on June 30, 2009 do hereby state that under requirements of PA 74, Michigan PA of 1970, the corner points mentioned in lines 1 and 2 above were in conformance with regulations and rules therefore as required in the current manual of survey instructions of the United States Department of the Interior, Bureau of Land Management or by a decree of a Court of Law and/or that the corner points mentioned in lines 3, 4 and 5 above were in conformance with the rules of the Michigan Board of Land Surveyors or by a Decree of a Court of Law; established, re-established, monumented, recovered, found as expressed below:

NOTE: Not more than 2 corners, all in the same town and range, may be recorded on this certificate.

	A	B	C	D	E	F	G	H	I	J	K	L	M
1													
2	6		5		4		3		2		1		
3													
4	7		8		9		10		11		12		
5													
6	18		17		16		15		14		13		
7													
8	19		20		21		22		23		24		
9													
10	30		29		28		27		26		25		
11													
12	31		32		33		34		35		36		
13													

A. Description of original monument and accessories and/or subsequent restoration:


- H13 – 1839 – GLO – Alvin Burt
 Beech 5" qr. Section corner
 1) Hemlock 20" N18°E 44 L.
 - **1865** – Wm. Slawson
 2) Sugar 14" S30°W 55
 3) Sugar 8" S31°E 64
 - **1974** – LCRC – L. 1, p. 93 – H. R. Bruning - Iron found;
 4) F. Post North 26.85'
 5) H. Maple 36" S84°W 58.81'
 - **No date** – BCRC corner record – Fd. 1" iron;
 6) 5/8" iron rod with cap N0°45'E 33.04';
 7) 14" Ironwood S66°W 88.78';
 8) 34" Cherry S24°E 14.56'

B. Description of corner evidence found and/or method applied in restoring or re-establishing corner:

H13 – Standard 1/4 corner common to Sec. 34, T26N, R14W – Fd. 1" x 36" iron rod per Bruning and Benzie Co. Rd. Commission. No GLO evidence. No evidence of Slawson BT's. Tree Row with old fence wire goes north from iron. Centerline of E-W gravel road is 5' North. Measured S24°E 14.57' to fd. nail and shiner in Dead 34" Cherry (#8). Witnesses #1, 2, 3 and 4 are gone. 1" iron rod accepted as the best available evidence of the position of a locally accepted corner.

C. Description of monument for corner and accessories established to perpetuate locating the position of the corner:

H13 – Replaced 1" x 36" iron rod with stamped 3" Benzie Co. Remonumentation
 Brass cap on 3/4" x 36" iron pipe encased in 4" x 36" concrete cylinder – Down 0.6' below grade.
 Set Blue Carsonite Post with loc. tag 33' S.
 North 33.01' to fd. 5/8" rebar (#6)
 S83°W 57.60' to set N & T in N. side 41" S. Maple (#5)
 S68°E 69.89' to set N & T in N. side 5" S. Maple
 N73°E 89.59' to set N & T in S. side 9" Elm
 S67°W 88.76' to set N & T at fd. nail and shiner in S. side Tw. 17" Ironwood (#7)

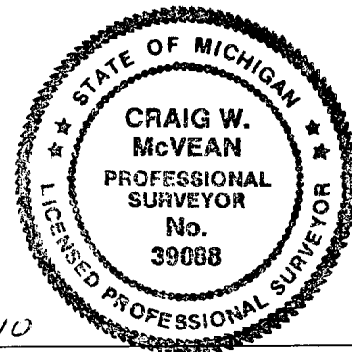

Signed by: Craig W. McVean
 Surveyor's Michigan License No.: 39088

Date: 1/7/2010